

1995 Alcona County Remonumentation Corner

LAND CORNER RECORDATION CERTIFICATE
Filing Requirement of Act 74, Mich. P.A. 1970

Alcona County Remonumentation
Liber 1 Page 120

For corners in Alcona
(County)

Located In:

Corner Code #

RECORDED

- 1. Public Land Survey T 25N R 6E
- 2. Property Controlling S _____ T _____ R _____
- 3. Miscellaneous S _____ T _____ R _____
- Property in Section S _____ T _____ R _____

K-7

APPROVED LAND CORNER
P.A. 345 of 1990
ALCONA COUNTY
Date: 7-21-1995
County Rep. E.T.L.

JUL 21 2 12 PM '95

David A. Smith
REGISTER OF DEEDS
ALCONA COUNTY MICHIGAN

Register of Deeds Stamp & File Number

- 4. Lot No. _____, Recorded Plat _____
- 5. Private Claims _____

A	B	C	D	E	F	G	H	I	J	K	L
2	6	5	4	3	2						
3											
4	7	8	9	10	11						
5											
6	18	17	16	15	14						
7											
8	19	20	21	22	23						
9											
10	30	29	28	27	26						
11											
12	31	32	33	34	35						
13											

I, David B. Guthrie in a field survey on May 23, 19 95, do hereby certify that under requirements of P.A. 74, Michigan P.A. of 1970, the corner points mentioned in lines 1 and 2 above were in conformance with regulations and rules therefore as required in the current manual of survey instructions of the United States Department of the Interior, Bureau of Land Management or by a decree of a Court of Law and/or that the corner points mentioned in lines 3, 4 and 5 above were in conformance with the rules of the Michigan Board of Professional Surveyors or by a Decree of a Court of Law; established, re-established, monumented, re-monumented, recovered, found as expressed below:

NOTE: Not more than 4 corners, all in the same town and range, may be recorded on this certificate.

A. Description of original monument and accessories and/or subsequent restoration:

- 1844: G.L.O. Survey by J.H. Mullett - Set post and referenced Beech 20 - N45E - 45 / Beech 18 - S43E - 46
- 1904: Survey by Edw. Chapelle - Post, Orig. B.T. found
- 1959: Survey by R.S. Scott Eng. Co. - Set Railroad spike
- 1976: Survey by Robert Griffin - Found 1/2" Iron Pipe
- 1989: Survey by D.R. MacNeill and Assoc. - Found 1/2" Iron Pipe
- 1993: Survey by D.R. MacNeill and Assoc. - Found 1/2" Iron Pipe

B. Description of corner evidence found and/or method applied in restoring or reestablishing corner:

1995: Found 1/2" Iron Pipe


SURVEY &
REMONUMENTATION

OCT 26 1995

COMMISSION

C. Description of monument for corner and accessories established to perpetuate locating the position of the corner:

- 1995: Set a 1/2" x 24" Iron Rod with an aluminum cap stamped to identify the corner placed 6" below the ground surface.
- Referenced: N74°E - 8" Basswood - 48.74 Feet
- N45°W - Utility Pole - 88.00 Feet
- West - 1/2" Iron Rod - 9.50 Feet
- S10°W - Fence Corner - 66.85 Feet
- S05°E - 3" R.Pine - 91.15 Feet

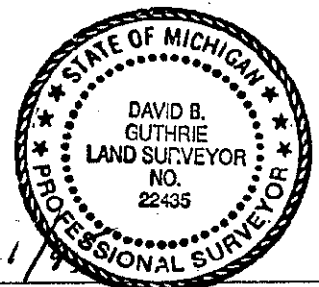

Signed by D.B. Guthrie

Date 7/21/95

Surveyor's Michigan License No. 22435