

LAND CORNER RECORDATION CERTIFICATE

Filing Requirement of Act 74, Mich. P.A. 1970

RECORDED

For corners in

Alcona
(County)

Located In:

Corner Code #

- 1. Public Land Survey T 25N R 6E
- T R
- T R
- T R
- 2. Property Controlling S T R
- in Section S T R
- 3. Miscellaneous S T R
- Property in Section S T R

K-9

APPROVED LAND CORNER
P A 345 of 1990
ALCONA COUNTY

Date July 21, 1995
County Rep. G. T. L.

JUL 21 2 12 PM '95

David A. Guthrie
REGISTER OF DEEDS
ALCONA COUNTY, MICHIGAN

Register of Deeds Stamp & File Number

- 4. Lot No. _____, Recorded Plat _____
- 5. Private Claims _____

A	B	C	D	E	F	G	H	I	J	K	L
2	6		5		4		3		2		1
3											
4	7		8		9		10		11		12
5											
6	18		17		16		15		14		13
7											
8	19		20		21		22		23		24
9											
10	30		29		28		27		26		25
11											
12	31		32		33		34		35		36
13											

I, David B. Guthrie in a field survey on May 25, 1995 do hereby certify that under requirements of P.A. 74, Michigan P.A. of 1970, the corner points mentioned in lines 1 and 2 above were in conformance with regulations and rules therefore as required in the current manual of survey instructions of the United States Department of the Interior, Bureau of Land Management or by a decree of a Court of Law and/or that the corner points mentioned in lines 3, 4 and 5 above were in conformance with the rules of the Michigan Board of Professional Surveyors or by a Decree of a Court of Law; established, re-established, monumented, re-monumented, recovered, found as expressed below:

NOTE: Not more than 4 corners, all in the same town and range, may be recorded on this certificate.

A. Description of original monument and accessories and/or subsequent restoration:

- 1844: G.L.O. Survey by J.H. Mullett - Set post and referenced B.Ash 14 - S75E - 10 / Maple 5 - N42W - 18
- 1904: Survey by Edw. Chapelle - Post
- 1959: Survey by R.S. Scott Eng. Co. - Set Railroad spike
- 1986: Survey by Ledy Eng. and Sur. - Found Railroad spike, set 5 x 5 x 36inc Concreté post with brass tablet.
- 1989: Survey by D.R. MacNeill and Assoc. - Found 1/2" re-rod

B. Description of corner evidence found and/or method applied in restoring or reestablishing corner:

1995: Found 5" x 5" Concrete post with brass tablet.

SURVEY &
REMONUMENTATION


OCT 26 1995

COMMISSION

C. Description of monument for corner and accessories established to perpetuate locating the position of the corner:

1995: Set a 1/2" x 18" Iron Rod with a brass cap stamped to identify the corner, directly over the 5" x 5" Concrete post with a brass tablet, placed in a monument box.

Referenced: S45°E - Fe. Cor. Post - 47.97 Feet
West - Fe. Cor. Post - 34.45 Feet
West - Utility Pole - 67.10 Feet
N55°E - Fe. Cor. Post - 54.54 Feet

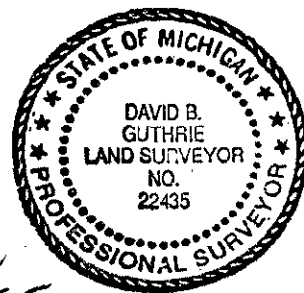

Signed by

David B. Guthrie

Date

7/21/95

Surveyor's Michigan License No.

22435