

LAND CORNER RECORDATION CERTIFICATE Filing Requirement of Act 74, Mich. P.A. 1970

RECORDED

For corners in

Alcona (County)

Located in:

Corner Code #

- 1. Public Land Survey T 25N R 6E
2. Property Controlling in Section S T R
3. Miscellaneous Property in Section S T R

K-12

APPROVED LAND CORNER P.A. 345 of 1990 ALCONA COUNTY Date 7-21-95 County Rep. E.J.L.

JUL 21 2 13 PM '95

David A. Guthrie REGISTER OF DEEDS ALCONA COUNTY MICHIGAN

Register of Deeds Stamp & File Number

- 4. Lot No. Recorded Plat
5. Private Claims


David B. Guthrie in a field survey on May 25, 1995, do hereby certify that under requirements of P.A. 74, Michigan P.A. of 1970, the corner points mentioned in lines 1 and 2 above were in conformance with regulations and rules therefore as required in the current manual of survey instructions of the United States Department of the Interior, Bureau of Land Management or by a decree of a Court of Law and/or that the corner points mentioned in lines 3, 4 and 5 above were in conformance with the rules of the Michigan Board of Professional Surveyors or by a Decree of a Court of Law; established, re-established, monumented, re-monumented, recovered, found as expressed below:

NOTE: Not more than 4 corners, all in the same town and range, may be recorded on this certificate.

A. Description of original monument and accessories and/or subsequent restoration:

- 1844: G.L.O. Survey by J.H. Mullett - Set post and referenced Y.Pine 18 - S26W - 22 / Y.Pine 14 - N25E - 46
1967: Survey by R.S. Scott Eng. Co. - Found 2" x 2" wood stake
1976: Survey by James Campbell - 1/2" Iron Pipe
1989: Survey by D.R. MacNeill and Assoc. - Found 1/2" Iron Pipe

B. Description of corner evidence found and/or method applied in restoring or reestablishing corner:

- 1995: Found 1/2" Iron Pipe and 2" x 2" wood stake


SURVEY & REMONUMENTATION

OCT 26 1995

COMMISSION

C. Description of monument for corner and accessories established to perpetuate locating the position of the corner:

- 1995: Set a 1/2" x 24" Iron Rod with an aluminum cap stamped to identify the corner placed 6" below the road surface. Referenced: N45°W - 18" Oak - 49.69 Feet, N70°E - 10" Ash - 21.85 Feet, S60°W - 6" W.Pine - 37.96 Feet, S54°E - 4" Ash - 20.40 Feet

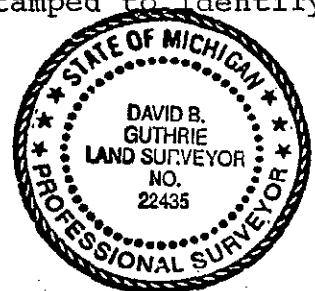

Signed by D.B. Guthrie

Date 7/21/95

Surveyor's Michigan License No. 22435