

1995 Alcona County Remonumentation Corner

Alcona County
Remonumentation
Liber _____ Page 130

LAND CORNER RECORDATION CERTIFICATE
Filing Requirement of Act 74, Mich. P.A. 1970

For corners in

Alcona
(County)

Located In:

Corner Code #

RECORDED

- | | | | | | |
|---|---|-----|---|----|------|
| 1. Public Land Survey | T | 25N | R | 6E | K-13 |
| | T | | R | | |
| | T | | R | | |
| | T | | R | | |
| 2. Property Controlling
in Section | S | | T | | R |
| | S | | T | | R |
| 3. Miscellaneous
Property in Section | S | | T | | R |
| | S | | T | | R |

APPROVED LAND CORNER
P A 345 of 1990
ALCONA COUNTY
Date 7-21-95
County Rep. E.T.L.

JUL 21 2 13 PM '95

David A. Guthrie
REGISTER OF DEEDS
ALCONA COUNTY MICHIGAN

Register of Deeds Stamp & File Number

4. Lot No. _____, Recorded Plat _____
5. Private Claims _____

A	B	C	D	E	F	G	H	I	J	K
2	6	5	4	3	2					
3										
4	7	8	9	10	11					
5										
6	18	17	16	15	14					
7										
8	19	20	21	22	23					
9										
10	30	29	28	27	26					
11										
12	31	32	33	34	35					
13										

I, David B. Guthrie in a field survey on June 2, 19 95, do hereby certify that under requirements of P.A. 74, Michigan P.A. of 1970, the corner points mentioned in lines 1 and 2 above were in conformance with regulations and rules therefore as required in the current manual of survey instructions of the United States Department of the Interior, Bureau of Land Management or by a decree of a Court of Law and/or that the corner points mentioned in lines 3, 4 and 5 above were in conformance with the rules of the Michigan Board of Professional Surveyors or by a Decree of a Court of Law; established, re-established, monumented, re-monumented, recovered, found as expressed below:

NOTE: Not more than 4 corners, all in the same town and range, may be recorded on this certificate.

A. Description of original monument and accessories and/or subsequent restoration:

- 1838: G.L.O. Survey by Lewis Clason - Set post and referenced Y.Pine 14 - N52E - 1.10 / Y.Pine 12 - N13E - 88
- 1957: Survey by Earl Winn - Found Concrete monument with brass cap
- 1967: Survey by R.S. Scott Eng. Co. - Found 1927 Gov't Cor.
- 1974: Survey by James Campbell - Found G.L.O. monument
- 1976: Survey by James Campbell - Found G.L.O. monument
- 1989: Survey by D.R. MacNeill and Assoc. - Found monument

B. Description of corner evidence found and/or method applied in restoring or reestablishing corner:

1995: Found Concrete post with brass cap.


SURVEY &
REMONUMENTATION

OCT 26 1995

COMMISSION

C. Description of monument for corner and accessories established to perpetuate locating the position of the corner:

- 1995: Concrete post with brass cap stamped to identify the corner.
- Referenced: N45°W - 12" Jack Pine - 14.25 Feet
- S55°W - 15" Oak - 27.55 Feet
- S10°E - 12" R.Pine - 17.76 Feet
- N25°E - 8" Oak - 19.10 Feet

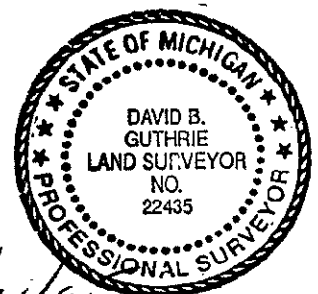

Signed by

David B. Guthrie

Date

7/21/95

Surveyor's Michigan License No. 22435