

LAND CORNER RECORDATION CERTIFICATE Filing Requirement of Act 74, Mich. P.A. 1970

For corners in Alcona (County) Located In: _____ Corner Code # _____

JUL 21 2 13 PM '95

- 1. Public Land Survey T 25N R 6E
- 2. Property Controlling in Section S _____ T _____ R _____
- 3. Miscellaneous Property in Section S _____ T _____ R _____

L-5
APPROVED LAND CORNER
P.A. 345 of 1990
ALCONA COUNTY
Date: 7-21-95
County: Alcona

Janice A. Mullett
REGISTER OF DEEDS
ALCONA COUNTY, MICHIGAN

Register of Deeds Stamp & File Number

- 4. Lot No. _____, Recorded Plat _____
- 5. Private Claims _____

	A	B	C	D	E	F	G	H	I	J	K	L
2	6	5	4	3	2							
3												
4	7	8	9	10	11							
5												
6	16	17	16	15	14							
7												
8	19	20	21	22	23							
9												
10	30	29	28	27	26							
11												
12	31	32	33	34	35							
13												

I, David B. Guthrie in a field survey on May 23, 1995 do hereby certify that under requirements of P.A. 74, Michigan P.A. of 1970, the corner points mentioned in lines 1 and 2 above were in conformance with regulations and rules therefore as required in the current manual of survey instructions of the United States Department of the Interior, Bureau of Land Management or by a decree of a Court of Law and/or that the corner points mentioned in lines 3, 4 and 5 above were in conformance with the rules of the Michigan Board of Professional Surveyors or by a Decree of a Court of Law; established, re-established, monumented, re-monumented, recovered, found as expressed below:


NOTE: Not more than 4 corners, all in the same town and range, may be recorded on this certificate.

- A. Description of original monument and accessories and/or subsequent restoration:
- 1844: G.L.O. Survey by J.H. Mullett - Set post and referenced Beech 18 - N14W - 26 / Beech 10 - S22E - 53
 - 1914: Survey by Andrew J. Freer - Gas pipe 30 in. long
 - 1972: Survey by Richard L. Miller

- B. Description of corner evidence found and/or method applied in restoring or reestablishing corner:
- 1995: Found 1/2" Iron Rod at the intersection of Hwy. F-30 and fence lines north and south.

SURVEY & REMONUMENTATION
OCT 26 1995
COMMISSION

- C. Description of monument for corner and accessories established to perpetuate locating the position of the corner:
- 1995: Set a 1/2" x 24" Iron Rod with a brass cap stamped to identify the corner placed in a monument box.
 - Referenced: N20°E - 24" Maple - 46.65 Feet
 - N24°W - 30" Oak - 44.00 Feet
 - S60°W - Twin 20" Maple - 72.52 Feet
 - S39°W - 8" Oak - 51.15 Feet

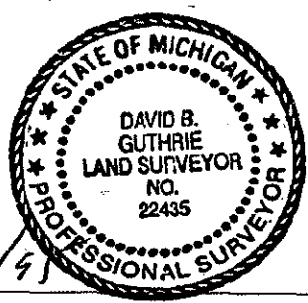

Signed by D.B. Guthrie
Surveyor's Michigan License No. 22435

Date 7/21/95