

**LAND CORNER RECORDATION CERTIFICATE**  
Filing Requirement of Act 74, Mich. P.A. 1970

For corners in Alcona (County) Located In: \_\_\_\_\_ Corner Code # \_\_\_\_\_

1. Public Land Survey T 25N R 6E M-6  
T \_\_\_\_\_ R \_\_\_\_\_  
T \_\_\_\_\_ R \_\_\_\_\_  
T \_\_\_\_\_ R \_\_\_\_\_

2. Property Controlling S \_\_\_\_\_ T \_\_\_\_\_ R \_\_\_\_\_  
in Section S \_\_\_\_\_ T \_\_\_\_\_ R \_\_\_\_\_

3. Miscellaneous S \_\_\_\_\_ T \_\_\_\_\_ R \_\_\_\_\_  
Property in Section S \_\_\_\_\_ T \_\_\_\_\_ R \_\_\_\_\_

RECORDED

JUL 21 2 13 PM '95

*David A. Smith*  
REGISTER OF DEEDS  
ALCONA COUNTY MICHIGAN

APPROVED LAND CORNER  
P A 345 of 1990  
ALCONA COUNTY  
Date 7-21-95  
County Rep E.L.L.

Register of Deeds Stamp & File Number

4. Lot No. \_\_\_\_\_, Recorded Plat \_\_\_\_\_  
5. Private Claims \_\_\_\_\_

	A	B	C	D	E	F	G	H	I	J	K
2	6		5		4		3		2		
3											
4	7		8		9		10		11		
5											
6	18		17		16		15		14		
7											
8	19		20		21		22		23		
9											
10	30		29		28		27		26		
11											
12	31		32		33		34		35		
13											

I, David B. Guthrie on a field survey on May 22, 19 95 do hereby certify that under requirements of P.A. 74, Michigan P.A. of 1970, the corner points mentioned in lines 1 and 2 above were in conformance with regulations and rules therefore as required in the current manual of survey instructions of the United States Department of the Interior, Bureau of Land Management or by a decree of a Court of Law and/or that the corner points mentioned in lines 3, 4 and 5 above were in conformance with the rules of the Michigan Board of Professional Surveyors or by a Decree of a Court of Law; established, re-established, monumented, re-monumented, recovered, found as expressed below:

**NOTE: Not more than 4 corners, all in the same town and range, may be recorded on this certificate.**

**A. Description of original monument and accessories and/or subsequent restoration:**

- 1838: G.L.O. Survey by Lewis Clason - Set post and referenced Hem. 18 - S46W - 36 / Hem. 24 - N77W - 10
- 1928: Dependent Resurvey by Guy R. Veal - Set Iron Post 3 Ft. long, 1 in. dia
- 1959: Survey by R.S. Scott Eng. Co. - Set Railroad Spike
- 1986: Survey by Ledy Eng. and Sur. - Set 36" x 5" x 5" Concrete post with a brass tablet.

**B. Description of corner evidence found and/or method applied in restoring or reestablishing corner:**

1995: Found 3/8" Iron Rod above a 36" x 5" x 5" Concrete post with a brass tablet


**SURVEY & REMONUMENTATION**

OCT 26 1995

COMMISSION

**C. Description of monument for corner and accessories established to perpetuate locating the position of the corner:**

- 1995: Set a 1/2" x 12" Iron Rod with an aluminum cap stamped to identify the corner above the 36" x 5" x 5" Concrete Monument with a brass tablet.
- Referenced: S40°E - 15" Maple - 70.63 Feet  
S37°W - 10" Aspen - 64.52 Feet  
S20°W - 14" Maple - 150.05 Feet  
S27°E - 24" Basswood - 58.18 Feet

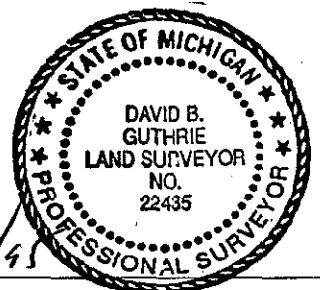

Signed by David B. Guthrie

Date 7/21/95

Surveyor's Michigan License No. 22435