

REMONUMENTATION

FEB 22 1996

COMMISSION

ALCONA COUNTY REMONUMENTATION
LAND CORNER RECORDATION CERTIFICATE
Filing Requirement of Act 74, Mich. P.A. 1970

Alcona County
Remonumentation
Liber 1 Page 141

For corners in

<u>ALCONA</u> (County)	Located In:	Corner Code #
1. Public Land Survey	<u>T25NR7E</u>	<u>A-5</u>
	T <u> </u> R <u> </u>	<u> </u>
	T <u> </u> R <u> </u>	<u> </u>
	T <u> </u> R <u> </u>	<u> </u>
2. Property Controlling in Section	S <u> </u> T <u> </u> R <u> </u>	<u> </u>
	S <u> </u> T <u> </u> R <u> </u>	<u> </u>
3. Miscellaneous Property in Sec.	S <u> </u> T <u> </u> R <u> </u>	<u> </u>
	S <u> </u> T <u> </u> R <u> </u>	<u> </u>

APPROVED LAND CORNER
P A 345 of 1990
ALCONA COUNTY

Date E.T.L.
County Rep. E.T.L.

RECORDED

DEC 20 4 35 PM '95

Janis A. Gauthier
REGISTER OF DEEDS
ALCONA COUNTY MICHIGAN

Register of Deeds Stamp & File Number

4. Lot No. _____, Recorded Plat _____
5. Private Claims _____

I, WILLIAM E. WOODS in a field survey on 12-12-, 1995 do hereby state that under requirements of P.A. 74, Michigan P.A. of 1970, the corner points mentioned in lines 1 and 2 above were in conformance with regulations and rules therefore as required in the current manual of survey instructions of the United States Department of the Interior, Bureau of Land Management or by a decree of a Court of Law and /or that the corner points mentioned in lines 3, 4 and 5 above were in conformance with the rules of the Michigan Board of Land Surveyors or by a Decree of a Court of Law; established, re-established, monumented, recovered, found as expressed below:

NOTE: Not more than 2 corners, all in the same town and range, may be recorded on this certificate.


	A	B	C	D	E	F	G	H	I	J	K	L	M	
1														
2	6			5			4			3			2	1
3														
4	7			8			9			10			11	12
5														
6	18			17			16			15			14	13
7														
8	19			20			21			22			23	24
9														
10	30			29			28			27			26	25
11														
12	31			32			33			34			35	36
13														

A. Description of original monument and accessories and/or subsequent restoration:
1843: G.L.O. SURVEY R.OAK 16" S43°W 26
BEECH 06" N49°W 32

B. Description of corner evidence found and/or method applied in restoring or reestablishing corner:
1928: INDEPENDENT RESURVEY SET 1" IRON PIPE WITH BRASS CAP.
1986: DUANE F. LEDY SET 36"X 5" CONCRETE POST WITH BRASS
TABLET. ASPEN 8" N14°E 60.20
RED OAK 18" N41°W 128.05
S.MAPLE 7" S20°E 88.18
B.OAK S15°W 259.60
3/4" IRON PIPE ON CENTERLINE OF ROADS
N79°W 3.11

C. Description of monument for corner and accessories established to perpetuate locating the position of the corner:
1995: REMONUMENTATION WILLIAM E. WOODS P.S. 25882

REMON TO USE 36" X 5" CONCRETE POST WITH BRASS TABLET AS ESTABLISHED BY
DUANE F. LEDY.
12" ASPEN N14°E, 60.20'
18" OAK, ONE OF A GROUP OF FIVE. N41°W, 128.05'
18" MAPLE, ONE OF THREE. S20°E, 88.18'
35" B.OAK S15°W, 259.60'
3/4" IRON PIPE ON CENTERLINES OF ROAD. N79°W, 3.11'

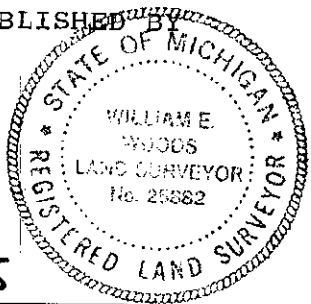

Signed by William E Woods
Surveyor's Michigan License No. 25882

Date 12-20-95