

REMONUMENTATION

FEB 22 1996

COMMISSION

ALCONA COUNTY REMONUMENTATION
LAND CORNER RECORDATION CERTIFICATE
Filing Requirement of Act 74, Mich. P.A. 1970

Alcona County
Remonumentation
Liber 1 Page 144

For corners in

<u>ALCONA</u> (County)	Located In:	Corner Code #
1. Public Land Survey	T <u>25NR</u> 7E	<u>C-4</u>
	T ___ R ___	___
	T ___ R ___	___
	T ___ R ___	___
2. Property Controlling in Section	S ___ T ___ R ___	___
	S ___ T ___ R ___	___
3. Miscellaneous Property in Sec.	S ___ T ___ R ___	___
	S ___ T ___ R ___	___

APPROVED LAND CORNER
P A 345 of 1990
ALCONA COUNTY

Date: _____
County Rep E.T.L.

RECORDED

DEC 20 4 39 PM '95

Doris A. Gauthier
REGISTER OF DEEDS
ALCONA COUNTY MICHIGAN

Register of Deeds Stamp & File Number

4. Lot No. _____, Recorded Plat _____
5. Private Claims _____

I, WILLIAM E. WOODS in a field survey on 12-12-, 1995 do hereby state that under requirements of P.A. 74, Michigan P.A. of 1970, the corner points mentioned in lines 1 and 2 above were in conformance with regulations and rules therefore as required in the current manual of survey instructions of the United States Department of the Interior, Bureau of Land Management or by a decree of a Court of Law and/or that the corner points mentioned in lines 3, 4 and 5 above were in conformance with the rules of the Michigan Board of Land Surveyors or by a Decree of a Court of Law; established, re-established, monumented, recovered, found as expressed below:


NOTE: Not more than 2 corners, all in the same town and range, may be recorded on this certificate.

	A	B	C	D	E	F	G	H	I	J	K	L	M
1													
2		6		5		4		3		2		1	
3													
4		7		8		9		10		11		12	
5													
6		10		17		16		15		14		13	
7													
8		19		20		21		22		23		24	
9													
10		30		29		28		27		26		25	
11													
12		31		32		33		34		35		36	
13													

A. Description of original monument and accessories and/or subsequent restoration:
1844: JAMES MULLETT SET POST.
HEMLOCK 6" S20°W 27
Y.PINE 16 N54°E 22

B. Description of corner evidence found and/or method applied in restoring or reestablishing corner:
1928: GUY R. VEAL MONU. 1" PIPE WITH BRASS CAP.
B.OAK 10" S72°E 281 LKS.
B.OAK 12" S42°W 324 LKS.
1982: ROBERT GRIFFIN FD. 1" PIPE WITH BRASS CAP.
POWER POLE N72E 96.85'
CEDAR POST S86W 23.09'
CEDAR POST NORTH 2.00'
B.OAK 9" S18E 24.30

C. Description of monument for corner and accessories established to perpetuate locating the position of the corner:
1995 REMONUMENTATION WILLIAM E. WOODS P.S. 25882
REMON TO USE BRASS CAP AT POSITION ESTABLISHED.
8" CEDAR CORNER FENCE POST S88°W 23.17
24" TRIPLE OAK S10°W 20.78 14" OAK S17°E 24.08
P.P. S83°E 89.23

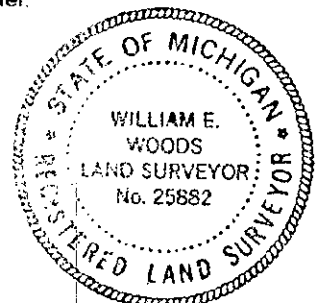

Signed by William E Woods
Surveyor's Michigan License No. 25882

Date 12-20-95