

REMONUMENTATION

FEB 22 1996

COMMISSION

ALCONA COUNTY REMONUMENTATION  
LAND CORNER RECORDATION CERTIFICATE  
Filing Requirement of Act 74, Mich. P.A. 1970

Alcona County  
Remonumentation  
Liber 7 Page 139

For corners in

ALCONA (County)	Located In:	Corner Code #
1. Public Land Survey	T25NR 7E	C-5
	T___R___	_____
	T___R___	_____
	T___R___	_____
2. Property Controlling in Section	S___T___R___	_____
	S___T___R___	_____
3. Miscellaneous Property in Sec.	S___T___R___	_____
	S___T___R___	_____

APPROVED LAND CORNER  
P.A. 345 of 1990  
ALCONA COUNTY

Date \_\_\_\_\_  
County Rep. E.T.L.

RECORDED

Dec 20 4 36 PM '95

*David A. Smith*  
REGISTER OF DEEDS  
ALCONA COUNTY MICHIGAN

Register of Deeds Stamp & File Number

4. Lot No. \_\_\_\_\_, Recorded Plat \_\_\_\_\_  
5. Private Claims \_\_\_\_\_

I, WILLIAM E. WOODS in a field survey on 12-12-, 19 95 do hereby state that under requirements of P.A. 74, Michigan P.A. of 1970, the corner points mentioned in lines 1 and 2 above were in conformance with regulations and rules therefore as required in the current manual of survey instructions of the United States Department of the Interior, Bureau of Land Management or by a decree of a Court of Law and /or that the corner points mentioned in lines 3, 4 and 5 above were in conformance with the rules of the Michigan Board of Land Surveyors or by a Decree of a Court of Law; established, re-established, monumented, recovered, found as expressed below:

NOTE: Not more than 2 corners, all in the same town and range, may be recorded on this certificate.

	A	B	C	D	E	F	G	H	I	J	K	L	M
1													
2	6		5			4		3		2		1	
3													
4	7		8			9		10		11		12	
5													
6	18		17			16		15		14		13	
7													
8	19		20			21		22		23		24	
9													
10	30		29			28		27		26		25	
11													
12	31		32			33		34		35		36	
13													

A. Description of original monument and accessories and/or subsequent restoration:

1844: JAMES MULLETT  
SET POST  
CEDAR 8" S67°E 18  
HEM 8" N70°W 25

B. Description of corner evidence found and/or method applied in restoring or reestablishing corner:


1928: INDEPENDENT RESURVEY  
FENCE POST N42°15E 73 LKS (48.18)  
14" CEDAR S17°E 68 LKS. (44.88)  
4" CEDAR S43°45'W 72 LKS. (47.52)  
4" BEECH N44°30'W 213 LKS. (140.58)  
1986: DUANE F. LEDY  
FD. CONCRETE MONUMENT WITH BRASS CAP.  
S 9.2' 4" CEDAR POST  
S38°E, 11.16' 8" CEDAR  
S78°W 27.09' 5" CEDAR  
N25°W 102.88' 5" CEDAR

C. Description of monument for corner and accessories established to perpetuate locating the position of the corner:

1995: REMONUMENTATION WILLIAM E. WOODS P.S. # 25882  
CONCRETE MONUMENT WITH BRASS CAP.

24" CEDAR N18°E 74.98  
8" CEDAR S38°E 11.64

6" BALSAM N58°E 36.00  
8" CEDAR S68°W 26.90

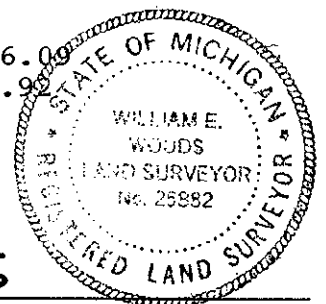

Signed by William E Woods  
Surveyor's Michigan License No. 25882

Date 12-20-95