REMONUMENTATION

FEB 2 2 1996

COMMISSION

ALCONA COUNTY REMONUMENTATION
LAND CORNER RECORDATION CERTIFICATE
Filing Requirement of Act 74, Mich. P.A. 1970

Alcona County
Remonumentation
Liber 1 Page 147

For corners in

ALCONA
(County)

	Located In:	Corner Code #
1. Public Land Survey	T25NR7E	D-1
	T___ R___	
	T___ R___	
	T___ R___	
2. Property Controlling in Section	S___ T___ R___	
	S___ T___ R___	
3. Miscellaneous Property in Sec.	S___ T___ R___	
	S___ T___ R___	

APPROVED LAND CORNER
P A 345 of 1990
ALCONA COUNTY

Date ___ County Rep. Entle

RECORDED

DEC 20 4 42 PM '95

Dave A Brother
REGISTER OF DEEDS
ALCONA COUNTY, MICHIGAN

Register of Deeds Stamp & File Number

4. Lot No. _____ , Recorded Plat _____
5. Private Claims _____

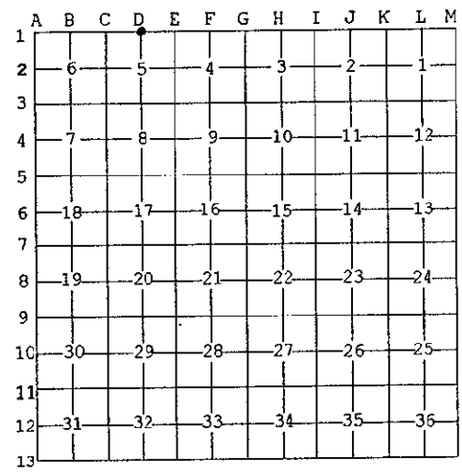

I, WILLIAM E. WOODS, in a field survey on 12-12-, 19 95 do hereby state that under requirements of P.A. 74, Michigan P.A. of 1970, the corner points mentioned in lines 1 and 2 above were in conformance with regulations and rules therefore as required in the current manual of survey instructions of the United States Department of the Interior, Bureau of Land Management or by a decree of a Court of Law and /or that the corner points mentioned in lines 3, 4 and 5 above were in conformance with the rules of the Michigan Board of Land Surveyors or by a Decree of a Court of Law; established, re-established, monumented, recovered, found as expressed below:

NOTE: Not more than 2 corners, all in the same town and range, may be recorded on this certificate.

A. Description of original monument and accessories and/or subsequent restoration:
NO ORIGINAL GOVERNMENT NOTES ON CLOSING CORNERS.

B. Description of corner evidence found and/or method applied in restoring or reestablishing corner:

1928: INDEPENDENT RESURVEY — SET AN IRON POST 1" DIAM.
W.OAK 8" DIAM. S1°E 76 LKS.
FORKED W.OAK 5" DIAM. S33°45'E 42 LKS.

1987: N.E.L.S. J. OLIVER — FOUND G.L.O. BRASS CAP.

C. Description of monument for corner and accessories established to perpetuate locating the position of the corner:

1995: REMONUMENTATION WILLIAM E. WOODS P.S. 25882

20" POPLAR N44°E 8.58
22" OAK S18°W 56.28
24" RED OAK S53°E 35.39
5" W.PINE S72°W 27.18

STATE OF MICHIGAN
WILLIAM E. WOODS
LAND SURVEYOR
No. 25882
REGISTERED LAND SURVEYOR

Signed by William E Woods
Surveyor's Michigan License No. 25882

Date 12-20-95

FORM APPROVED BY MICHIGAN STATE BOARD OF PROFESSIONAL SURVEYORS, JAN. 28, 197
REVISED MAY 14,197
REVISED JAN., 198
REVISED OCT., 199