

REMONUMENTATION

FEB 22 1996

COMMISSION

ALCONA COUNTY REMONUMENTATION  
LAND CORNER RECORDATION CERTIFICATE  
Filing Requirement of Act 74, Mich. P.A. 1970

Alcona County  
Remonumentation  
Liber 1 Page 151

For corners in

<u>ALCONA</u> (County)	Located in:	Corner Code #
1. Public Land Survey	T <u>25</u> R <u>7E</u>	<u>E-1</u>
	T <u>   </u> R <u>   </u>	<u>   </u>
	T <u>   </u> R <u>   </u>	<u>   </u>
	T <u>   </u> R <u>   </u>	<u>   </u>
2. Property Controlling in Section	S <u>   </u> T <u>   </u> R <u>   </u>	<u>   </u>
	S <u>   </u> T <u>   </u> R <u>   </u>	<u>   </u>
3. Miscellaneous Property in Sec.	S <u>   </u> T <u>   </u> R <u>   </u>	<u>   </u>
	S <u>   </u> T <u>   </u> R <u>   </u>	<u>   </u>

APPROVED LAND CORNER  
P.A. 345 of 1990  
ALCONA COUNTY  
Date Feb 1 1996  
County Rep. E.D.L.

RECORDED

FEB 1 4 43 PM '96

*Janis A. Gauthier*  
REGISTER OF DEEDS  
ALCONA COUNTY MICHIGAN

Register of Deeds Stamp & File Number

4. Lot No. \_\_\_\_\_, Recorded Plat \_\_\_\_\_  
5. Private Claims \_\_\_\_\_

WILLIAM E. WOODS in a field survey on 12-19, 1995 do hereby state that under requirements of P.A. 74, Michigan P.A. of 1970, the corner points mentioned in lines 1 and 2 above were in conformance with regulations and rules therefore as required in the current manual of survey instructions of the United States Department of the Interior, Bureau of Land Management or by a decree of a Court of Law and/or that the corner points mentioned in lines 3, 4 and 5 above were in conformance with the rules of the Michigan Board of Land Surveyors or by a Decree of a Court of Law; established, re-established, monumented, recovered, found as expressed below:

NOTE: Not more than 2 corners, all in the same town and range, may be recorded on this certificate.


	A	B	C	D	E	F	G	H	I	J	K	L	M
1													
2	6			5		4		3		2		1	
3													
4	7			8		9		10		11		12	
5													
6	18			17		16		15		14		13	
7													
8	19			20		21		22		23		24	
9													
10	30			29		28		27		26		25	
11													
12	31			32		33		34		35		36	
13													

A. Description of original monument and accessories and/or subsequent restoration:  
1844: JAMES MULLETT SET POST. HEM 20" S45°E 23  
HEM 18" S52°W 34

B. Description of corner evidence found and/or method applied in restoring or reestablishing corner:  
1911: ANDREW J. FREER GRAY BOULDER WITH X ON TOP.  
1928: INDEPENDENT RE SURVEY ESTABLISHED CORNER. B.OAK 4" DIAM. BEARS N46°30'E., 188LKS. 124.08 BEECH 5" DIAM. BEARS S12°E., 105 LKS 69.30  
1987: N.E.L.S./ BILL WOODS FOUND 1/2" BAR FOR CORNER. NO WITNESSES. DISTANCE MEASURED WEST TO D-1 GOVERNMENT RECORDED 2639.34 MEASURED 2641.56 DISTANCE MEASURED SOUTH TO E-2 GOVERNMENT RECORDED 2232.12 MEASURED 2232.37

C. Description of monument for corner and accessories established to perpetuate locating the position of the corner:  
1995: REMONUMENTATION WILLIAM E. WOODS P.S. 25882  
1/2" BAR WITH ALUMINUM CAP.

P.P. N30°E SPK S.E. SIDE 85.92  
16" W.PINE S30°E SPK. S.W. SIDE 63.32  
12" W. PINE S35°E SPK. N.W. SIDE 86.68  
20" BLACK OAK N60°W SPK. S.W. SIDE 58.09

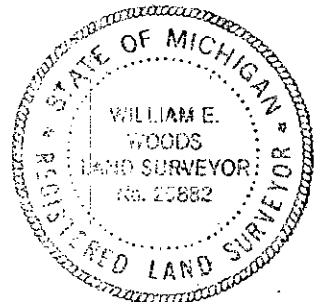

Signed by William E Woods  
Surveyor's Michigan License No. 25882

Date 12-20-95