

REMONUMENTATION

FEB 22 1996

COMMISSION

ALCONA COUNTY REMONUMENTATION
LAND CORNER RECORDATION CERTIFICATE
Filing Requirement of Act 74, Mich. P.A. 1970

Alcona County
Remonumentation
Liber 1 Page 146

For corners in

ALCONA (County)	Located In:	Corner Code #
1. Public Land Survey	T 25N R 7E	H-1
	T R	
	T R	
	T R	
2. Property Controlling in Section	S T R	
	S T R	
3. Miscellaneous Property in Sec.	S T R	
	S T R	

APPROVED LAND CORNER
P A 345 of 1990
ALCONA COUNTY

Date: _____
County Rep E.T.L.

RECORDED

DEC 20 4 41 PM '95

Doris A. Benthien
REGISTER OF DEEDS
ALCONA COUNTY, MICHIGAN

Register of Deeds Stamp & File Number

4. Lot No. _____, Recorded Plat _____
5. Private Claims _____

I, WILLIAM E. WOODS in a field survey on 12-12-, 19 95 do hereby state that under requirements of P.A. 74, Michigan P.A. of 1970, the corner points mentioned in lines 1 and 2 above were in conformance with regulations and rules therefore as required in the current manual of survey instructions of the United States Department of the Interior, Bureau of Land Management or by a decree of a Court of Law and /or that the corner points mentioned in lines 3, 4 and 5 above were in conformance with the rules of the Michigan Board of Land Surveyors or by a Decree of a Court of Law; established, re-established, monumented, recovered, found as expressed below:


NOTE: Not more than 2 corners, all in the same town and range, may be recorded on this certificate.

	A	B	C	D	E	F	G	H	I	J	K	L	M
1													
2	6		5			4		3		2		1	
3													
4	7		8			9		10		11		12	
5													
6	18		17			16		15		14		13	
7													
8	19		20			21		22		23		24	
9													
10	30		29			28		27		26		25	
11													
12	31		32			33		34		35		36	
13													

A. Description of original monument and accessories and/or subsequent restoration:
NO ORIGINAL GOVERNMENT NOTES ON CLOSING CORNERS.

B. Description of corner evidence found and/or method applied in restoring or reestablishing corner:
1911: ANDREW J. FREER IRON BOLT 32" LONG 1 1/2" DIAM. BUR ON TOP 2 1/2 X 2 1/2 SQUARE. NO WITNESSES.
1928: INDEPENDENT RE SURVEY W.BIRCH 5" DIAM., BEARS S63°30"E., 88 LKS. NO OTHER BEARING TREES AVAILABLE.
1993: THOMAS L. FABIS SET 1/2" IRON ROD. 8" TWIN CHERRY S56°W 44.35
4" W.BIRCH S38°E 71.09 3" W.BIRCH N43°E 53.25

C. Description of monument for corner and accessories established to perpetuate locating the position of the corner:
1995: REMONUMENTATION, WILLIAM E. WOODS P.S. 25882
USE 1/2" IRON ROD AS ESTABLISHED BY THOMAS L. FABIS. SET ALUMINUM CAP.
8" TWIN CHERRY S56°W- 44.35 3"W.BIRCH S38°E 71.09'
4" W.BIRCH N40°W 49.52' 3" TWIN W. BIRCH S38°E 71.09'

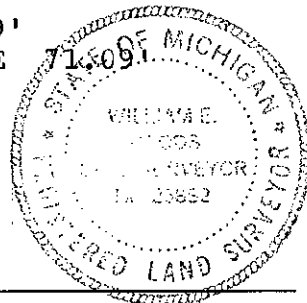

Signed by William E Woods
Surveyor's Michigan License No. 25882

Date 12-20-95