

REMONUMENTATION

FEB 22 1996

COMMISSION

ALCONA COUNTY REMONUMENTATION  
LAND CORNER RECORDATION CERTIFICATE  
Filing Requirement of Act 74, Mich. P.A. 1970

Alcona County  
Remonumentation  
Liber 1 Page 159

For corners in

ALCONA (County)	Located In:	Corner Code #
1. Public Land Survey	T <sup>25</sup> R 8	G-1
	T R	
	T R	
	T R	
2. Property Controlling in Section	S T R	
	S T R	
3. Miscellaneous Property in Sec.	S T R	
	S T R	

APPROVED LAND CORNER  
P A 345 of 1990  
ALCONA COUNTY  
Date 2-1-96  
County Rep E.T.L.

RECORDED

FEB 1 4 42 PM '96

*Janis A. Smith*  
REGISTER OF DEEDS  
ALCONA COUNTY MICHIGAN

Register of Deeds Stamp & File Number

4. Lot No. \_\_\_\_\_, Recorded Plat \_\_\_\_\_  
5. Private Claims \_\_\_\_\_

I, WILLIAM E. WOODS in a field survey on 01-16-, 1996 do hereby state that under requirements of P.A. 74, Michigan P.A. of 1970, the corner points mentioned in lines 1 and 2 above were in conformance with regulations and rules therefore as required in the current manual of survey instructions of the United States Department of the Interior, Bureau of Land Management or by a decree of a Court of Law and/or that the corner points mentioned in lines 3, 4 and 5 above were in conformance with the rules of the Michigan Board of Land Surveyors or by a Decree of a Court of Law; established, re-established, monumented, recovered, found as expressed below:

NOTE: Not more than 2 corners, all in the same town and range, may be recorded on this certificate.

	A	B	C	D	E	F	G	H	I	J	K	L	M
1													
2	6		5		4		3		2		1		
3													
4	7		8		9		10		11		12		
5													
6	18		17		16		15		14		13		
7													
8	19		20		21		22		23		24		
9													
10	30		29		28		27		26		25		
11													
12	31		32		33		34		35		36		
13													

A. Description of original monument and accessories and/or subsequent restoration:

1842: GOVERNMENT SURVEY SET POST.  
HEM 8" S12°E 25  
HEM 8" S82°W 22


B. Description of corner evidence found and/or method applied in restoring or reestablishing corner:

1974: RICHARD L. MILLER CORNER SHOWN ON SURVEY. NOT SAID WHAT HE FOUND.  
1975: NORTHEAST LAND SURVEYS JOHN OLIVER USED CORNERS SHOWN BY RICHARD L. MILLER  
1977: RICHARD L. MILLER SET PK NAIL WEST 51.48. CORRECTED DIST. FROM SOUTH ESTABLISHED BY OSTLING SURVEYS. N50°E 97.0' P.P.  
N45°W 43.89' P.P.  
S45°W 49.04' IRON PIPE.

C. Description of monument for corner and accessories established to perpetuate locating the position of the corner:

1995: REMONUMENTATION WILLIAM E. WOODS P.S. 25882  
SET 1/2" BAR WITH ALUMINUM CAP IN MONUMENT BOX.

STEEL UTILITY POST (GTE) N38°W 43.04  
P.P. NEW N60°E 96.36  
10" ASH S50°W 71.78  
18" ASH S24°W 104.61

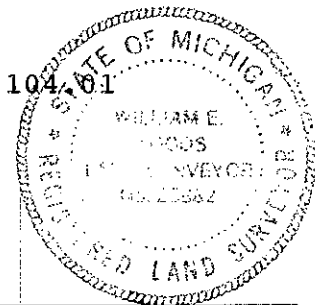

Signed by William E Woods  
Surveyor's Michigan License No. 25882

Date 1-30-96