

REMONUMENTATION

FEB 22 1996

COMMISSION

ALCONA COUNTY REMONUMENTATION
LAND CORNER RECORDATION CERTIFICATE
Filing Requirement of Act 74, Mich. P.A. 1970

Alcona County
Remonumentation
Liber 1 Page 156
RECORDED

For corners in

ALCONA (County)	Located In:	Corner Code #
1. Public Land Survey	T 25 N R 8 E	G-3
	T R	
	T R	
	T R	
2. Property Controlling in Section	S T R	
	S T R	
3. Miscellaneous Property in Sec.	S T R	
	S T R	

APPROVED LAND CORNER
P A 345 of 1990
ALCONA COUNTY
Date 2-1-96
County Rep. E.T.L.

FEB 1 4 43 PM '96

Doris A. Guthrie
REGISTER OF DEEDS
ALCONA COUNTY MICHIGAN

Register of Deeds Stamp & File Number

4. Lot No. _____, Recorded Plat _____
5. Private Claims _____

I, WILLIAM E. WOODS on a field survey on 1-16, 19-96 do hereby state that under requirements of P.A. 74, Michigan P.A. of 1970, the corner points mentioned in lines 1 and 2 above were in conformance with regulations and rules therefore as required in the current manual of survey instructions of the United States Department of the Interior, Bureau of Land Management or by a decree of a Court of Law and/or that the corner points mentioned in lines 3, 4 and 5 above were in conformance with the rules of the Michigan Board of Land Surveyors or by a Decree of a Court of Law; established, re-established, monumented, recovered, found as expressed below:


1	A	B	C	D	E	F	G	H	I	J	K	L	M
2		6		5		4		3		2		1	
3													
4		7		8		9		10		11		12	
5													
6		18		17		16		15		14		13	
7													
8		19		20		21		22		23		24	
9													
10		30		29		28		27		26		25	
11													
12		31		32		33		34		35		36	
13													

NOTE: Not more than 2 corners, all in the same town and range, may be recorded on this certificate.

A. Description of original monument and accessories and/or subsequent restoration:
1843: GOVERNMENT SURVEY SET POST. 0.9.LK.
W.PINE 10 N55°E CHANGED TO N 47°E
W.PINE 16 N71°W CHANGED TO N 62°E 20

B. Description of corner evidence found and/or method applied in restoring or reestablishing corner:
1977: RICHARD L. MILLER FOUND IRON PIPE ESTABLISHED BY R.J. COOKE RLS.
S85°E 55.85 BIRCH TREE S70°W 34.50 POST
N60°W 38.18 POST

C. Description of monument for corner and accessories established to perpetuate locating the position of the corner:
1995: REMONUMENTATION WILLIAM E. WOODS P.S. 25882
5/8" BAR WITH ALUMINUM CAP. IN MONUMENT BOX.
6" MAPLE S52°E 65.45 POST S70°W 33.84
POST N45°W 38.71 10" MAPLE WITH BEARING TREE PLATE.
N70°E 67.62

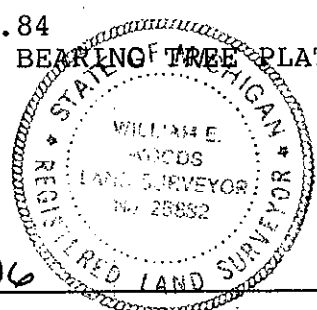

Signed by William E Woods
Surveyor's Michigan License No. 25882

Date 1-30-96