

REMONUMENTATION

FEB 22 1996  
 ALCONA COUNTY REMONUMENTATION  
 LAND CORNER RECORDATION CERTIFICATE  
 Filing Requirement of Act 74, Mich. P.A. 1970

Alcona County  
 Remonumentation  
 Liber 1 Page 163

For corners in

| ALCONA<br>(County)                    | Located In: | Corner Code # |
|---------------------------------------|-------------|---------------|
| 1. Public Land Survey                 | T25NR8E     | G-8           |
|                                       | T R         |               |
|                                       | T R         |               |
|                                       | T R         |               |
| 2. Property Controlling<br>in Section | S T R       |               |
|                                       | S T R       |               |
| 3. Miscellaneous<br>Property in Sec.  | S T R       |               |
|                                       | S T R       |               |

APPROVED LAND CORNER  
 P A 345 of 1990  
 ALCONA COUNTY  
 Date 2-1-96  
 County Rep. E. T. L.

RECORDED

FEB 1 4 42 PM '96

*Janis A. Gauthier*  
 REGISTER OF DEEDS  
 ALCONA COUNTY MICHIGAN

Register of Deeds Stamp & File Number

4. Lot No. \_\_\_\_\_, Recorded Plat \_\_\_\_\_  
 5. Private Claims \_\_\_\_\_

I, WILLIAM E. WOODS in a field survey on 1-16-, 1996 do hereby state that under requirements of P.A. 74, Michigan P.A. of 1970, the corner points mentioned in lines 1 and 2 above were in conformance with regulations and rules therefore as required in the current manual of survey instructions of the United States Department of the Interior, Bureau of Land Management or by a decree of a Court of Law and/or that the corner points mentioned in lines 3, 4 and 5 above were in conformance with the rules of the Michigan Board of Land Surveyors or by a Decree of a Court of Law; established, re-established, monumented, recovered, found as expressed below:

NOTE: Not more than 2 corners, all in the same town and range, may be recorded on this certificate.

|    | A  | B | C  | D | E  | F | G  | H | I  | J | K  | L | M |
|----|----|---|----|---|----|---|----|---|----|---|----|---|---|
| 1  |    |   |    |   |    |   |    |   |    |   |    |   |   |
| 2  | 6  |   | 5  |   | 4  |   | 3  |   | 2  |   | 1  |   |   |
| 3  |    |   |    |   |    |   |    |   |    |   |    |   |   |
| 4  | 7  |   | 8  |   | 9  |   | 10 |   | 11 |   | 12 |   |   |
| 5  |    |   |    |   |    |   |    |   |    |   |    |   |   |
| 6  | 18 |   | 17 |   | 16 |   | 15 |   | 14 |   | 13 |   |   |
| 7  |    |   |    |   |    |   |    |   |    |   |    |   |   |
| 8  | 19 |   | 20 |   | 21 |   | 22 |   | 23 |   | 24 |   |   |
| 9  |    |   |    |   |    |   |    |   |    |   |    |   |   |
| 10 | 30 |   | 29 |   | 28 |   | 27 |   | 26 |   | 25 |   |   |
| 11 |    |   |    |   |    |   |    |   |    |   |    |   |   |
| 12 | 31 |   | 32 |   | 33 |   | 34 |   | 35 |   | 36 |   |   |
| 13 |    |   |    |   |    |   |    |   |    |   |    |   |   |

A. Description of original monument and accessories and/or subsequent restoration:

1843: GOVERNMENT SURVEY SET POST. BEECH 10" N31°W 10  
 CEDAR 6" S42°E 20 NBT W.PINE STUMP: 22" N1°E 6

B. Description of corner evidence found and/or method applied in restoring or reestablishing corner:


1995: JOHN OLIVER FOUND 1/2" BAR. NO WITNESSES.

C. Description of monument for corner and accessories established to perpetuate locating the position of the corner:

1995: REMONUMENTATION WILLIAM E. WOODS P.S. 25882  
 SET 1/2" BAR WITH ALUMINUM CAP IN MONUMENT BOX.

24" W.PINE N37°W 56.0  
 12" T.MAPLE S75°E 35.86


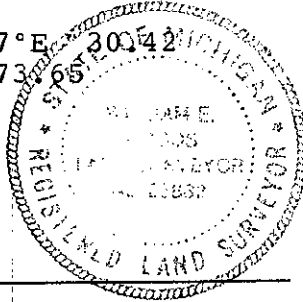

Signed by William E Woods  
 Surveyor's Michigan License No. 25882

Date 1-30-96