

REMONUMENTATION

FEB 22 1996
COMMISSION

ALCONA COUNTY REMONUMENTATION
LAND CORNER RECORDATION CERTIFICATE
Filing Requirement of Act 74, Mich. P.A. 1970

Alcona County
Remonumentation
Liber 1 Page 154

For corners in

<u>ALCONA</u> (County)	Located In:	Corner Code #
1. Public Land Survey	T25 R 8	G-9
	T R	
	T R	
	T R	
2. Property Controlling in Section	S T R	
	S T R	
3. Miscellaneous Property in Sec.	S T R	
	S T R	
4. Lot No. _____, Recorded Plat _____		
5. Private Claims _____		

APPROVED LAND CORNER
P.A. 345 of 1990
ALCONA COUNTY
Date 2-1-96
County Rep. E.T.L.

RECORDED

FEB 1 4 43 PM '96

Doris A. Gauthier
REGISTER OF DEEDS
ALCONA COUNTY, MICHIGAN

Register of Deeds Stamp & File Number

I, WILLIAM E. WOODS in a field survey on 1-16-1996 do hereby state that under requirements of P.A. 74, Michigan P.A. of 1970, the corner points mentioned in lines 1 and 2 above were in conformance with regulations and rules therefore as required in the current manual of survey instructions of the United States Department of the Interior, Bureau of Land Management or by a decree of a Court of Law and /or that the corner points mentioned in lines 3, 4 and 5 above were in conformance with the rules of the Michigan Board of Land Surveyors or by a Decree of a Court of Law; established, re-established, monumented, recovered, found as expressed below:

A	B	C	D	E	F	G	H	I	J	K	L	M
1												
2	6	5	4	3	2	1						
3												
4	7	8	9	10	11	12						
5												
6	18	17	16	15	14	13						
7												
8	19	20	21	22	23	24						
9												
10	30	29	28	27	26	25						
11												
12	31	32	33	34	35	36						
13												


NOTE: Not more than 2 corners, all in the same town and range, may be recorded on this certificate.

- A. Description of original monument and accessories and/or subsequent restoration:
- 1843: GOVERNMENT SURVEY SET POST
MAPLE 8" N80°E 15
MAPLE 10" S23°E 19

 - B. Description of corner evidence found and/or method applied in restoring or reestablishing corner:
 - 1901: COUNTY SURVEY SET POST 10 LKS. WEST OF LARGE BOULDER
IN CENTER OF ROAD.
 - 1962: SCOTT ENGINEERING 1" PIPE P.P. N45°E 118.0
P.P. N45°W 105.0

 - 1973: JAMES CAMPBELL SURVEY L. 152 P. 446 FOUND 1" PIPE
N45°E P.P. 118
N45°W P.P. 105

 - C. Description of monument for corner and accessories established to perpetuate locating the position of the corner:
 - 1995: REMONUMENTATION WILLIAM E. WOODS P.S. 25882
1/2" BAR WITH ALUMINUM CAP IN MONUMENT BOX.
26" WILLOW N55°W 105.61 P.P. N64°E 117.61
CORNER FENCE POST S43°E 62.60 P.P. S65°W 134.35

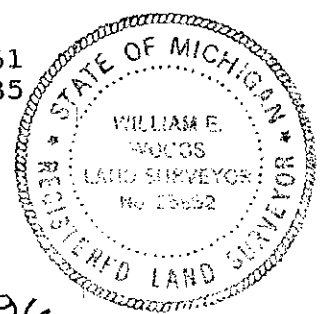

Signed by William E Woods
Surveyor's Michigan License No. 25882

Date 1-30-96