

REMONUMENTATION

FEB 22 1996

COMMISSION

ALCONA COUNTY REMONUMENTATION
LAND CORNER RECORDATION CERTIFICATE
Filing Requirement of Act 74, Mich. P.A. 1970

Alcona County
Remonumentation
Liber 1 Page 155
RECORDED

For corners in

<u>ALCONA</u> (County)	Located In:	Corner Code #
1. Public Land Survey	T <u>25</u> R <u>8</u>	<u>H-1</u>
	T <u> </u> R <u> </u>	<u> </u>
	T <u> </u> R <u> </u>	<u> </u>
	T <u> </u> R <u> </u>	<u> </u>
2. Property Controlling in Section	S <u> </u> T <u> </u> R <u> </u>	<u> </u>
	S <u> </u> T <u> </u> R <u> </u>	<u> </u>
3. Miscellaneous Property in Sec.	S <u> </u> T <u> </u> R <u> </u>	<u> </u>
	S <u> </u> T <u> </u> R <u> </u>	<u> </u>
4. Lot No. <u> </u> , Recorded Plat <u> </u>		
5. Private Claims <u> </u>		

APPROVED LAND CORNER
P.A. 345 of 1990
ALCONA COUNTY
Date 2-1-96
County Rep. E.T.L.

FEB 1 4 43 PM '96

Doris A. Genthner
REGISTER OF DEEDS
ALCONA COUNTY MICHIGAN

Register of Deeds Stamp & File Number

I, WILLIAM E. WOODS a field survey on 1-16-1996 do hereby state that under requirements of P.A. 74, Michigan P.A. of 1970, the corner points mentioned in lines 1 and 2 above were in conformance with regulations and rules therefore as required in the current manual of survey instructions of the United States Department of the Interior, Bureau of Land Management or by a decree of a Court of Law and/or that the corner points mentioned in lines 3, 4 and 5 above were in conformance with the rules of the Michigan Board of Land Surveyors or by a Decree of a Court of Law; established, re-established, monumented, recovered, found as expressed below:

NOTE: Not more than 2 corners, all in the same town and range, may be recorded on this certificate.

	A	B	C	D	E	F	G	H	I	J	K	L	M
1													
2	6		5			4		3		2		1	
3													
4	7		8			9		10		11		12	
5													
6	18		17			16		15		14		13	
7													
8	19		20			21		22		23		24	
9													
10	30		29			28		27		26		25	
11													
12	31		32			33		34		35		36	
13													

A. Description of original monument and accessories and/or subsequent restoration:
NO ORIGINAL GOVERNMENT NOTES FOR THIS CORNER.


B. Description of corner evidence found and/or method applied in restoring or reestablishing corner:
1975: NORTHEAST LAND SURVEYS JOHN OLIVER
DID SECTION SUB. SET CORNER MIDWAY AND ON LINE 22.8 WEST OF FENCE.

C. Description of monument for corner and accessories established to perpetuate locating the position of the corner:
1995: REMONUMENTATION WILLIAM WOODS P.S. 25882

1/2" BAR WITH ALUMINUM CAP.

36" MAPLE S20°W 42.40
P.P. N11°E 54.88
3/4" PIPE EAST 22.86

6" ASH S31°E 51.44
36" W.PINE N45°W 104.45

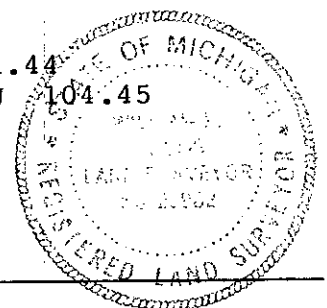

Signed by William E Woods
Surveyor's Michigan License No. 25882

Date 1-30-96