

REMONUMENTATION

FEB 22 1996

COMMISSION

For corners in

ALCONA COUNTY REMONUMENTATION
LAND CORNER RECORDATION CERTIFICATE
Filing Requirement of Act 74, Mich. P.A. 1970

Alcona County
Remonumentation
Liber 1 Page 152

ALCONA (County)	Located In:	Corner Code #
1. Public Land Survey	T 25R 8	I-1
	T R	
	T R	
	T R	
2. Property Controlling in Section	S T R	
	S T R	
3. Miscellaneous Property in Sec.	S T R	
	S T R	

APPROVED LAND CORNER
P.A. 345 of 1990
ALCONA COUNTY

Date February 1, 1996
County Rep. E. J. L.

RECORDED

FEB 1 4 43 PM '96

Janis A. Bantner
REGISTER OF DEEDS
ALCONA COUNTY MICHIGAN

Register of Deeds Stamp & File Number

4. Lot No. _____, Recorded Plat _____
5. Private Claims _____

WILLIAM E. WOODS in a field survey on 1-16-1996 do hereby state that under requirements of P.A. 74, Michigan P.A. of 1970, the corner points mentioned in lines 1 and 2 above were in conformance with regulations and rules therefore as required in the current manual of survey instructions of the United States Department of the Interior, Bureau of Land Management or by a decree of a Court of Law and for that the corner points mentioned in lines 3, 4 and 5 above were in conformance with the rules of the Michigan Board of Land Surveyors or by a Decree of a Court of Law; established, re-established, monumented, recovered, found as expressed below:

	A	B	C	D	E	F	G	H	I	J	K	L	M
1													
2	6	5	4	3	2	1							
3													
4	7	8	9	10	11	12							
5													
6	18	17	16	15	14	13							
7													
8	19	20	21	22	23	24							
9													
10	30	29	28	27	26	25							
11													
12	31	32	33	34	35	36							
13													

NOTE: Not more than 2 corners, all in the same town and range, may be recorded on this certificate.

A. Description of original monument and accessories and/or subsequent restoration:

1843: JAMES MULLETT

INTERSECT NORTH BOUNDARY AT POST.
ASPIN 11" S75°E 46
ASPIN 10" S70°W 58

B. Description of corner evidence found and/or method applied in restoring or reestablishing corner:

COUNTY SURVEYOR

NO BEARING TREES.
GRAY BOULDER 12" TRIANGLE SHAPE WITH
CROCKERY UNDERNEATH.

1975: NORTHEAST LAND SURVEYS

FOUND 1/2" BAR.

C. Description of monument for corner and accessories established to perpetuate locating the position of the corner:

1995: REMONUMENTATION WILLIAM E. WOODS P.S. 25882


1/2" BAR WITH ALUMINUM CAP

P.P. N51°E 62.75

FENCE CORNER N39°W 59.05

UNDERGROUND CABLE TELEPHONE SIGN S.W. CORNER S45°E 49.47

STREET SIGN- MCCONNELL AN X-MARK IN
SIGN POST N19°W 54.25

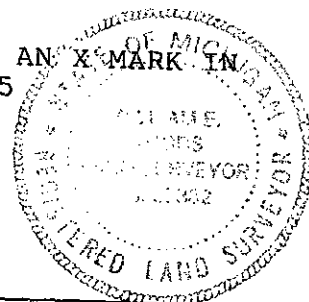

Signed by William E. Woods
Surveyor's Michigan License No. 25882

Date 1-30-96