

REMONUMENTATION

FEB 22 1996

ALCONA COUNTY REMONUMENTATION
 COMMISSION LAND CORNER RECORDATION CERTIFICATE
 Filing Requirement of Act 74, Mich. P.A. 1970

Alcona County
 Remonumentation
 Liber 7 Page 158

For corners in

ALCONA (County)	Located In:	Corner Code #
1. Public Land Survey	T 25N R 8E	I-3
	T R	
	T R	
	T R	
2. Property Controlling in Section	S T R	
	S T R	
3. Miscellaneous Property in Sec.	S T R	
	S T R	

APPROVED LAND CORNER
 P A 345 of 1990
 ALCONA COUNTY
 Date: 2-1-96
 County Rep: ST.L.

RECORDED

FEB 1 4 42 PM '96

Doris A. Bantner
 REGISTER OF DEEDS
 ALCONA COUNTY MICHIGAN

Register of Deeds Stamp & File Number

4. Lot No. _____, Recorded Plat _____
 5. Private Claims _____

I, WILLIAM E. WOODS in a field survey on 1-16-1996 do hereby state that under requirements of P.A. 74, Michigan P.A. of 1970, the corner points mentioned in lines 1 and 2 above were in conformance with regulations and rules therefore as required in the current manual of survey instructions of the United States Department of the Interior, Bureau of Land Management or by a decree of a Court of Law and /or that the corner points mentioned in lines 3, 4 and 5 above were in conformance with the rules of the Michigan Board of Land Surveyors or by a Decree of a Court of Law; established, re-established, monumented, recovered, found as expressed below:

NOTE: Not more than 2 corners, all in the same town and range, may be recorded on this certificate.

	A	B	C	D	E	F	G	H	I	J	K	L	M
1													
2	6		5			4		3		2			1
3									●				
4	7		8			9		10		11			12
5													
6	18		17			16		15		14			13
7													
8	19		20			21		22		23			24
9													
10	30		29			28		27		26			25
11													
12	31		32			33		34		35			36
13													

A. Description of original monument and accessories and/or subsequent restoration:

1843: GOVERNMENT SURVEY W. PINE 7" S49°E 24
 JAMES MULLETT ASPIN 8" N59°W 25

B. Description of corner evidence found and/or method applied in restoring or reestablishing corner:

COUNTY SURVEY W. PINE STUMP 10" S83½°W 21 W. PINE STUMP 9" N74°E 49

1977: RICHARD L. MILLER SET 1/8" ROD AT ROAD TO NORTH & FENCE TO EAST.
 RECORDED LIBER 1 PAGE 68. N40°W 51.12' FENCE POST. DUE EAST 33.0'
 FENCE POST. DUE SOUTH 8.88' 10" JACK PINE.

1982: BILL WOODS FOUND 1" IRON PIPE 2.5' BELOW ROAD SURFACE. NO WITNESSES. RAISED TO SURFACE.


1986: JOHN OLIVER FOUND 1" PIPE. NO WITNESSES.

1989: JOHN OLIVER FOUND 1" PIPE. NO WITNESSES.

1992: BILL WOODS FOUND 1" PIPE NO WITNESSES.

C. Description of monument for corner and accessories established to perpetuate locating the position of the corner:

1995: REMONUMENTATION WILLIAM E. WOODS P.S. 25882
 1/2" BAR WITH ALUMINUM CAP. S61°W 6" BALSAM 40.91
 S3°E 8" APPLE TREE 45.55 S38°E 8" RED PINE 51.73
 N65°W P.P. 75.01

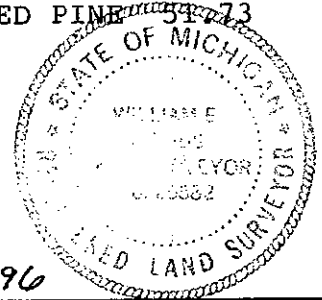

Signed by William E Woods
 Surveyor's Michigan License No. 25882

Date 1-30-96