

REMONUMENTATION

FEB 22 1996

ALCONA COUNTY REMONUMENTATION
LAND CORNER RECORDATION CERTIFICATE
Filing Requirement of Act 74, Mich. P.A. 1970

Alcona County
Remonumentation
Liber 1 Page 162

For corners in

COMMISSION

ALCONA (County)	Located In:	Corner Code #
1. Public Land Survey	T <u>25</u> R <u>8</u>	<u>T-13</u>
	T <u> </u> R <u> </u>	<u> </u>
	T <u> </u> R <u> </u>	<u> </u>
	T <u> </u> R <u> </u>	<u> </u>
2. Property Controlling in Section	S <u> </u> T <u> </u> R <u> </u>	<u> </u>
	S <u> </u> T <u> </u> R <u> </u>	<u> </u>
3. Miscellaneous Property in Sec.	S <u> </u> T <u> </u> R <u> </u>	<u> </u>
	S <u> </u> T <u> </u> R <u> </u>	<u> </u>

APPROVED LAND CORNER
P A 345 of 1990
ALCONA COUNTY

Date 2-1-96
County Rep. E.T.L.

RECORDED

FEB 1 4 42 PM '96

Doris A. Gauthier
REGISTER OF DEEDS
ALCONA COUNTY MICHIGAN

Register of Deeds Stamp & File Number

4. Lot No. _____, Recorded Plat _____
5. Private Claims _____

I, WILLIAM E. WOODS, in a field survey on 1-16- 1996 do hereby state that under requirements of P.A. 74, Michigan P.A. of 1970, the corner points mentioned in lines 1 and 2 above were in conformance with regulations and rules therefore as required in the current manual of survey instructions of the United States Department of the Interior, Bureau of Land Management or by a decree of a Court of Law and /or that the corner points mentioned in lines 3, 4 and 5 above were in conformance with the rules of the Michigan Board of Land Surveyors or by a Decree of a Court of Law; established, re-established, monumented, recovered, found as expressed below:

NOTE: Not more than 2 corners, all in the same town and range, may be recorded on this certificate.

	A	B	C	D	E	F	G	H	I	J	K	L	M
1													
2		6		5		4		3		2		1	
3													
4		7		8		9		10		11		12	
5													
6		18		17		16		15		14		13	
7													
8		19		20		21		22		23		24	
9													
10		30		29		28		27		26		25	
11													
12		31		32		33		34		35		36	
13													

A. Description of original monument and accessories and/or subsequent restoration:
1843: GOVERNMENT SURVEY

SET POST.
W. ASH 4" N44°W 35LK.
B. CHERRY 4" N89°E 46 LK.


B. Description of corner evidence found and/or method applied in restoring or reestablishing corner:
1980: NORTHEAST LAND SURVEYS

FOUND 1/2" BAR AT CENTERLINE
INTERSECTION MEASURED 5264 EAST AND
AND ON LINE WITH WEST 1/4 AND
NORTHWEST CORNER OF SECTION 35.

C. Description of monument for corner and accessories established to perpetuate locating the position of the corner:
1995: REMONUMENTATION WILLIAM E. WOODS P.S. 25882
SET 1/2" BAR WITH ALUMINUM CAP IN MONUMENT BOX.

20" W. PINE N50°E 75.00
6" W. PINE S60°W 63.35
36" W. PINE N25°W 102.73

BLD. N.W. COR. INDIAN CHURCH
S32°E 61.40

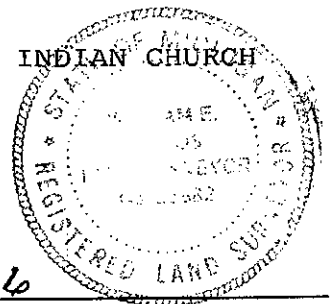

Signed by William E Woods
Surveyor's Michigan License No. 25882

Date 1-30-96