

# LAND CORNER RECORDATION CERTIFICATE

## FILING REQUIREMENT OF ACT 74, MICH. P.A.1970

1998 Alcona County Remonumentation

FOR CORNERS OF--:	LOCATED IN--:	CORNER CODE NUMBER
1. PUBLIC LAND SURVEY_____	T. 25N N. S., R. 8E E. W.	K-1
2. PROPERTY CONTROLLING IN SECTION_____	, T. _____ N. S., R. _____ E. W.	_____
3. MISCELLANEOUS PROPERTY IN SECTION_____	, T. _____ N. S., R. _____ E. W.	_____
4. LOT NO. _____, RECORDED PLAT _____		
5. PRIVATE CLAIMS _____		

APPROVED LAND CORNER  
P A 345 of 1990  
ALCONA COUNTY

Date. 9/22/98  
County Rep D.B. Oliver

Filed for Record in  
ALCONA COUNTY MICHIGAN  
DORIS A GAUTHIER  
On 10-21-1998 At 11:21:12  
LAND CORNER 9.00  
OR


REGISTER OF DEEDS STAMP AND  
FILING NUMBER

Alcona County Remonumentation Page 295 Liber

**SURVEY & REMONUMENTATION**  
**NOV 25 1998**

I, John F. Oliver do hereby certify that under requirements of P.A. 74, Michigan P.A. of 1970, the corner points mentioned in lines 1 and 2 above (identified with circles on index code diagram - over) were, in a field survey on Oct. 6, 1998, established, re-established, monumented, re-monumented, recovered or restored as expressed below and in conformance with regulations and rules therefore as required in the current manual of survey instructions of the United States Department of the Interior, Bureau of Land Management or by a decree of a court of law. Furthermore, that the corner points mentioned in lines 3, 4 and 5 above were, in a field survey on \_\_\_\_\_ 19\_\_\_\_, found, recovered, restored, established or re-established as expressed below and in conformance with the rules of the Michigan State Board of Registration for Land Surveyors or, by a Decree of a Court of law:

- A. Description of original monument and accessories and/or subsequent restoration:
- K-1: 1843:GLO survey by J. Mullett-set post and referenced survey-date unknown- entered into GLO notes- Co. Surveyor N.B.T. gray boulder 6 x 10 with + on top
  - 1956: survey by MDOT for M-171-cor. not shown on plans-drawing indicates centerline of rd. and distance to unidentified cor. to the West-fence shown to the East
  - 1990: sur.Hen. Eng. rd; align.- fd. 1/2" rod & cap (no number)
- B. Description of corner evidence found and/or method applied in restoring or re-establishing corner:
- K-1: found "PK" nail in centerline of F-41 Hwy. and Tait Road with 1/2" bar and cap 26.40 ft East - also conc. R/W post 50.0 ft East "PK" is found to be on line between SE cor. Sec. 35, T26N, R8E, and N-1/4 cor. Sec. 2, T25N, R8E. The distances and alignment are compatible with MDOT Plans location. Accepted as the correct location for the corner.
  - no evidence recovered from GLO survey of 1843
- C. Description of monument for corner and accessories established to perpetuate locating the position of the corner:
- K-1: placed 1/2" bar with brass cap in a pavement box referenced:
    - tel. pole / S 68°W / 56.25 ft
    - 18" Spruce / N 15°W / 115.04 ft
    - 9" tw. Ash / N 23°E / 168.40 ft
    - 14" Spruce / N 62°W / 57.54 ft

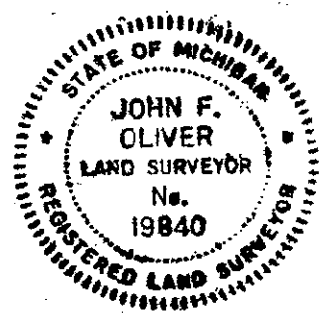

SIGNED BY \_\_\_\_\_ DATE Oct. 6, 1998  
John F. Oliver  
SURVEYOR'S MICHIGAN REGISTRATION NO. 19840 (SEAL)

FOR STATE AND UNITED STATES AGENCIES:  
SIGNED BY \_\_\_\_\_ DATE \_\_\_\_\_  
CHIEF OF SURVEY PARTY  
APPROVED AND SIGNED BY \_\_\_\_\_ DATE \_\_\_\_\_  
MICHIGAN REGISTERED LAND SURVEYOR (SEAL)