

LAND CORNER RECORDATION CERTIFICATE

FILING REQUIREMENT OF ACT 74, MICH. P.A.1970

1998 Alcona County Remonumentation

FOR CORNERS OF--:	LOCATED IN--:	CORNER CODE NUMBER
1. PUBLIC LAND SURVEY _____	T. 25N S., R. 8E E. W.	K-8
2. PROPERTY CONTROLLING IN SECTION _____	T. _____ N. S., R. _____ E. W.	
3. MISCELLANEOUS PROPERTY IN SECTION _____	T. _____ N. S., R. _____ E. W.	
4. LOT NO. _____, RECORDED PLAT _____		
5. PRIVATE CLAIMS _____		

APPROVED LAND CORNER
Act 74 of 1990
ALCONA COUNTY

Date 9/22/98
County Rep D. B. C.

0
Filed for Record in
ALCONA COUNTY MICHIGAN
DORIS A GAUTHIER
On 10-21-1998 At 11:21:44 am
LAND CORNER 9.00
OR

REGISTER OF DEEDS STAMP AND
FILING NUMBER

Alcona County Remonumentation Page 302 Liber 7

SURVEY & REMONUMENTATION

NOV 25 1998

SECTION

I, John F. Oliver do hereby certify that under requirements of P.A. 74, Michigan P.A. of 1970, the corner points mentioned in lines 1 and 2 above (identified with circles on index code diagram - over) were, in a field survey on Oct. 2, 1998, established, re-established, monumented, re-monumented, recovered or restored as expressed below and in conformance with regulations and rules therefore as required in the current manual of survey instructions of the United States Department of the Interior, Bureau of Land Management or by a decree of a court of law. Furthermore, that the corner points mentioned in lines 3, 4 and 5 above were, in a field survey on _____ 19____, found, recovered, restored, established or re-established as expressed below and in conformance with the rules of the Michigan State Board of Registration for Land Surveyors or, by a Decree of a Court of law:

A. Description of original monument and accessories and/or subsequent restoration:

K-8; 1843: GLO survey by J. Mullett - set post and referenced
1956: survey by MDOT for M-171 - no cor. shown on Plans
1962: survey for Plat Golden Sunset by R.J. Cooke - cor. shown
1968: survey by R.J. Cooke - cor. shown - not described
1970: survey by Scott Eng. - cor. is fd. bolt
1978: survey by NE Surveys - cor. is fd. bolt
1993: survey by NE Surveys - cor. is fd. 1/2" bar

B. Description of corner evidence found and/or method applied in restoring or re-establishing corner:


K-8; found railroad spike - distances are compatible with R.J. Cooke survey, L. 137, p. 603-4 and NE Survey survey, L. 278, p. 282. this location was accepted as the correct location for the corner

no evidence recovered from GLO survey of 1843

C. Description of monument for corner and accessories established to perpetuate locating the position of the corner:

K-8; placed pavement box with 1/2" bar and brass cap referenced:

13" Spruce / N 60°W / 96.84 ft
13" Cedar / S 53°W / 89.18 ft
8" Cedar / S 20°E / 139.35 ft
tel. pole / N 32°E / 145.85 ft

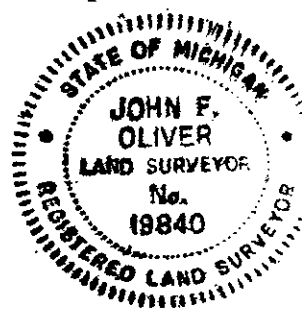

SIGNED BY John F. Oliver DATE Oct. 2, 1998
SURVEYOR'S MICHIGAN REGISTRATION NO. 19840 (SEAL)

FOR STATE AND UNITED STATES AGENCIES:

SIGNED BY _____ DATE _____
CHIEF OF SURVEY PARTY

APPROVED AND SIGNED BY _____ DATE _____
MICHIGAN REGISTERED LAND SURVEYOR (SEAL)

SURVEYOR'S MICHIGAN REGISTRATION NO. _____