

REMONUMENTATION

FEB 22 1996

COMMISSION

ALCONA COUNTY REMONUMENTATION
LAND CORNER RECORDATION CERTIFICATE
Filing Requirement of Act 74, Mich. P.A. 1970

Alcona County
Remonumentation
Liber 1 Page 157

For corners in

ALCONA	Located in:	Corner Code #	
(County)			
1. Public Land Survey	T <u>25</u> R <u>8</u>	<u>K-13</u>	
	T <u> </u> R <u> </u>	<u> </u>	
	T <u> </u> R <u> </u>	<u> </u>	
	T <u> </u> R <u> </u>	<u> </u>	
2. Property Controlling in Section	S <u> </u> T <u> </u> R <u> </u>	<u> </u>	
	S <u> </u> T <u> </u> R <u> </u>	<u> </u>	
3. Miscellaneous Property in Sec.	S <u> </u> T <u> </u> R <u> </u>	<u> </u>	
	S <u> </u> T <u> </u> R <u> </u>	<u> </u>	

APPROVED LAND CORNER
 P. A. 345 of 1990
 ALCONA COUNTY
 Date 1-30-96
 County Rep. E. J. J. C.

RECORDED

FEB 1 4 42 PM '96

Marie A. Panther
 REGISTER OF DEEDS
 ALCONA COUNTY MICHIGAN

Register of Deeds Stamp & File Number

4. Lot No. _____, Recorded Plat _____
 5. Private Claims _____

I, WILLIAM E. WOODS in a field survey on 1-16-, 19 96, do hereby state that under requirements of P.A. 74, Michigan P.A. of 1970, the corner points mentioned in lines 1 and 2 above were in conformance with regulations and rules therefore as required in the current manual of survey instructions of the United States Department of the Interior, Bureau of Land Management or by a decree of a Court of Law and/or that the corner points mentioned in lines 3, 4 and 5 above were in conformance with the rules of the Michigan Board of Land Surveyors or by a Decree of a Court of Law; established, re-established, monumented, recovered, found as expressed below:

NOTE: Not more than 2 corners, all in the same town and range, may be recorded on this certificate.

	A	B	C	D	E	F	G	H	I	J	K	L	M
1													
2	6		5		4		3		2		1		
3													
4	7		8		9		10		11		12		
5													
6	18		17		16		15		14		13		
7													
8	19		20		21		22		23		24		
9													
10	30		29		28		27		26		25		
11													
12	31		32		33		34		35		36		
13													

A. Description of original monument and accessories and/or subsequent restoration:

1843: JAMES MULLETT
 SET POST
 HEM 12" N51°W 32
 HEM 12" N37°E 32


B. Description of corner evidence found and/or method applied in restoring or reestablishing corner:

1980: NORTHEAST LAND SURVEYS
 JOHN OLIVER
 FOUND 1/2" BAR IN MONUMENT BOX.
 NO WITNESSES. MEASURED 5264.0
 WEST TO SOUTHWEST COR. SEC. 35
 AND SHOW'S COR. ON LINE WITH E.
 1/4 AND N.E. SEC. COR. MEASURED
 AND RECORDED AT 2579.81 NORTH TO
 EAST 1/4 CORNER

C. Description of monument for corner and accessories established to perpetuate locating the position of the corner:

1995: REMONUMENTATION WILLIAM E. WOODS P.S. 25882
 PAVEMENT BOX WITH 1/2" BAR WITH ALUMINUM CAP.

N45°W P.P. 72.62 S34°W P.P. 47.98
 S67°E P.P. 137.50 N81°E P.P. 167.20

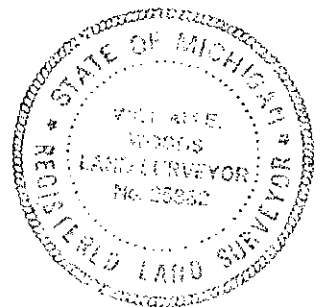

Signed by William E Woods
 Surveyor's Michigan License No. 25882

Date 1-30-96