

DEC 16 1996

1996 Alcona County Remonumentation Corner

LAND CORNER RECORDATION CERTIFICATE  
Filing Requirement of Act 74, Mich. P.A. 1970

For corners in Alcona (County) Located In: Corner Code #

1. Public Land Survey T 25N R 8E M-3  
 T 25N R 9E A-3  
 T \_\_\_\_\_ R \_\_\_\_\_  
 T \_\_\_\_\_ R \_\_\_\_\_

2. Property Controlling in Section S \_\_\_\_\_ T \_\_\_\_\_ R \_\_\_\_\_  
 S \_\_\_\_\_ T \_\_\_\_\_ R \_\_\_\_\_

3. Miscellaneous Property in Section S \_\_\_\_\_ T \_\_\_\_\_ R \_\_\_\_\_  
 S \_\_\_\_\_ T \_\_\_\_\_ R \_\_\_\_\_

RECORDED  
OCT 9 10 22 AM 1996  
APPROVED LAND CORNER  
P.A. 345 of  
ALCONA COUNTY  
Date: 10-9-96  
County: Alcona  
Alcona County Remonumentation Liber 1 Page 179

Register of Deeds Stamp & File Number

4. Lot No. \_\_\_\_\_, Recorded Plat \_\_\_\_\_  
5. Private Claims \_\_\_\_\_

I, David B. Guthrie in a field survey on October 5, 19 96, do hereby certify that under requirements of P.A. 74, Michigan P.A. of 1970, the corner points mentioned in lines 1 and 2 above were in conformance with regulations and rules therefore as required in the current manual of survey instructions of the United States Department of the Interior, Bureau of Land Management or by a decree of a Court of Law and/or that the corner points mentioned in lines 3, 4 and 5 above were in conformance with the rules of the Michigan Board of Professional Surveyors or by a Decree of a Court of Law; established, re-established, monumented, re-monumented, recovered, found as expressed below:


	A	B	C	D	E	F	G	H	I	J	K	L	M
2	6		5		4		3		2		1		
3													
4	7		8		9		10		11		12		
5													
6	18		17		16		15		14		13		
7													
8	19		20		21		22		23		24		
9													
10	30		29		28		27		26		25		
11													
12	31		32		33		34		35		36		
13													

NOTE: Not more than 4 corners, all in the same town and range, may be recorded on this certificate.

A. Description of original monument and accessories and/or subsequent restoration:  
1837: G.L.O. Survey by Lewis Clason - Set Post and referenced  
W. Birch 8 - S69W - 26 / W. Birch 11 - N52W - 22

B. Description of corner evidence found and/or method applied in restoring or reestablishing corner:  
1996: Established Corner by extension of the East line of the Southeast 1/4 of the Northeast 1/4 of Section 12 to the North.  
The East 1/4 Corner of Section 12 is monumented with a 1/2" Iron Pipe, the Northeast Corner of the Southeast 1/4 of the Northeast 1/4 is monumented with the intersection of the County Road North South and the County Road East.

C. Description of monument for corner and accessories established to perpetuate locating the position of the corner:  
1996: Set a 1/2" x 24" Iron Rod with an Aluminum Cap stamped to identify the corner 6" below the road surface.  
Referenced: N50°E - 10" Cedar - 42.50 Feet  
East - 10" Cedar - 38.90 Feet  
N85°W - 6" Ash - 31.10 Feet  
S15°E - 7" Birch - 64.30 Feet

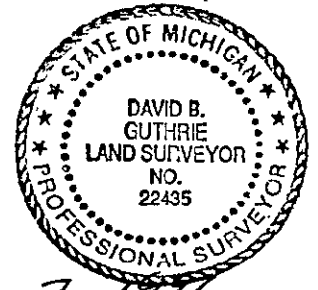

Signed by David B. Guthrie Date Oct. 7, 1996  
Surveyor's Michigan License No. 22435