

LAND CORNER RECORDATION CERTIFICATE

FILING REQUIREMENT OF ACT 74, MICH. P.A.1970

FOR CORNERS OF--:	LOCATED IN--:	CORNER CODE NUMBER
1. PUBLIC LAND SURVEY _____	T. 25 ^{N.} ● R. 8 ^{E.} ●	H-7'
2. PROPERTY CONTROLLING IN SECTION 15 _____	T. 25 ^{N.} ● R. 8 ^{E.} ●	9'; 16'
3. MISCELLANEOUS PROPERTY IN SECTION _____	T. _____ ^{N.} ● R. _____ ^{E.} ●	
4. LOT NO. _____, RECORDED PLAT _____		
5. PRIVATE CLAIMS _____		

~~Katkester~~
Alcona

REGISTER OF DEEDS STAMP AND FILING NUMBER _____

I, Kenneth J. Ostling do hereby certify that under requirements of P.A. 74, Michigan P.A. of 1970, the corner points mentioned in lines 1 and 2 above (identified with circles on index code diagram - over) were, in a field survey on June 12, 1974, established, re-established, monumented, re-monumented, recovered or restored as expressed below and in conformance with regulations and rules therefore as required in the current manual of survey instructions of the United States Department of the Interior, Bureau of Land Management or by a decree of a court of law. Furthermore, that the corner points mentioned in lines 3, 4 and 5 above were, in a field survey on _____ 19____, found, recovered, restored, established or re-established as expressed below and in conformance with the rules of the Michigan State Board of Registration for Land Surveyors or, by a Decree of a Court of law:

A. Description of original monument and accessories and/or subsequent restoration:


B. Description of corner evidence found and/or method applied in restoring or re-establishing corner:

- H-7 Set corner at N-S fence line and 33' south of E-W fence, which seems to concur with Scott survey procedure for the N-S line of Section 15.
- 9 Set by standard survey procedure for the subdivision of sections.
- 16 Set by standard survey procedure.

C. Description of monument for corner and accessories established to perpetuate locating the position of the corner:

	9	16
Set DNR monument	Set 2½' of 1" pipe	Set 2½' of 1" pipe
12" Maple S45°W 28.9	5" Cedar N44°E 31.3	4" Cedar S69°E 53.9
Fence post N17°W 5.9	1½" pipe by gate post N9°W 27.3	6" Tw. W. Birch N11°E 33.8
3" Maple West 36.2	NE cor. of cabin N43°W 54.3	Iron bar 7.4' north and 1.6' east
	face of large clump of soft maple South 9.3	

SIGNED BY Kenneth J. Ostling DATE 6/21/74
 SURVEYOR'S MICHIGAN REGISTRATION NO. 100 68

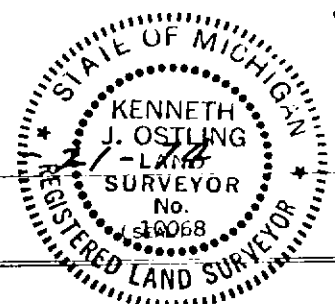

FOR STATE AND UNITED STATES AGENCIES:

SIGNED BY _____ DATE _____
CHIEF OF SURVEY PARTY

APPROVED AND SIGNED BY _____ DATE _____
MICHIGAN REGISTERED LAND SURVEYOR

(SEAL)

SURVEYOR'S MICHIGAN REGISTRATION NO. _____

ALCONA COUNTY