

2000 Alcona County Remonumentation

LAND CORNER RECORDATION CERTIFICATE
Filing Requirement of Act 74, Mich. P.A. 1970

For corners in
Alcona

(County)

Located In:

Corner Code #

- 1. Public Land Survey T 25NR 09E C-1 ✓
T R
T R
T R
- 2. Property Controlling S T R
in Section S T R
- 3. Miscellaneous S T R
Property in Sec. S T R

Alcona County
Remonumentation

Liber 2 Page 86

Filed for Record in
ALCONA COUNTY MICHIGAN
DORIS A GAUTHIER
On 09-20-2000 At 09:54 am.
LAND CORNER 9.00

Register of Deeds Stamp & File Number

- 4. Lot No. _____, Recorded Plat _____
- 5. Private Claims _____

I, Wayne T. Lewis, in a field survey on 3-30-2000, 19____ do hereby state that under requirements of P.A. 74, Michigan P.A. of 1970, the corner points mentioned in lines 1 and 2 above were in conformance with regulations and rules therefore as required in the current manual of survey instructions of the United States Department of the Interior, Bureau of Land Management or by a decree of a Court of Law and/or that the corner points mentioned in lines 3, 4 and 5 above were in conformance with the rules of the Michigan Board of Land Surveyors or by a Decree of a Court of Law; established, re-established, monumented, recovered, found as expressed below:

NOTE: Not more than 2 corners, all in the same town and range, may be recorded on this certificate.

	A	B	C	D	E	F	G	H	I	J	K	L	M
1			●										
2	6		5		4		3		2		1		
3													
4	7		8		9		10		11		12		
5													
6	10		17		16		15		14		13		
7													
8	19		20		21		22		23		24		
9													
10	30		29		28		27		26		25		
11													
12	31		32		33		34		35		36		
13													

A. Description of original monument and accessories and/or subsequent restoration:

- 1843 - James A. Mullet: Set post 20 links East of standard corner and witnessed
- 1993 - Northeast Land Surveys: Found 3/4" pinch pipe, 13.16 feet East of 3/8" rod with 1/2" pipe over, no witnesses given
- 1999 - John F. Oliver, P.S.: Used corner for section breakdown, no monumentation or witnesses given

APPROVED LAND CORNER
P A 345 of 1990
ALCONA COUNTY

Date: 9-6-2000
County Rep. [Signature]

B. Description of corner evidence found and/or method applied in restoring or reestablishing corner:

Found 1/2" galvanized pinch pipe, 13.20 feet East of 1/4" rod, in 3/4" pipe w/cap (unidentifiable)


This corner position is accepted as a careful and faithful perpetuation of the position of the original corner.

C. Description of monument for corner and accessories established to perpetuate locating the position of the corner:

2000 - Placed 3" Alcona County cap, stamped to identify the corner, on 1/2" rered driven next to pipe

Witnesses:

- N 05° W 17.99' 10" Cedar (set tag #41922)
- N 50° E 5.77' 10" Ash (set tag #41922)
- S 60° E 31.58' 14" Basswood (set tag #41922)
- S 30° W 1.21' 18" Cedar (set tag #41922)
- West 13.19' 1/2" Pipe w/nail

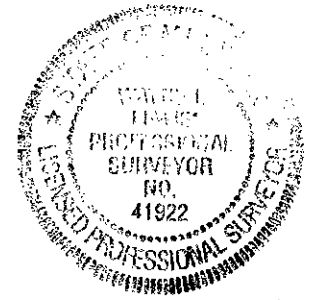

Signed by [Signature]
Surveyor's Michigan License No. 41922

Date September 14, 2000

SURVEY &
REMONUMENTATION

FORM APPROVED BY MICHIGAN STATE BOARD OF PROFESSIONAL SURVEYORS, JAN. 28, 1971
REVISED MAY 14, 1975
REVISED JAN., 1983
REVISED OCT., 1985

FEB 07 2001

SECTION