

2000 Alcona County Remonumentation

LAND CORNER RECORDATION CERTIFICATE
Filing Requirement of Act 74, Mich. P.A. 1970

For corners in
Alcona
(County)

Located In: _____ Corner Code # _____

1. Public Land Survey T 25NR 09E C-3 ✓
T _____
T _____
T _____

2. Property Controlling S _____
in Section S _____
3. Miscellaneous S _____
Property in Sec. S _____

Alcona County
Remonumentation
Liber 2 Page 89

Filed for Record in
ALCONA COUNTY MICHIGAN
DORIS A GAUTHIER
On 09-20-2000 At 09:54 am.
LAND CORNER 9.00

Register of Deeds Stamp & File Number

4. Lot No. _____, Recorded Plat _____
5. Private Claims _____

I, Wayne T. Lewis, in a field survey on 3-30-2000, 19____ do hereby state that under requirements of P.A. 74, Michigan P.A. of 1970, the corner points mentioned in lines 1 and 2 above were in conformance with regulations and rules therefore as required in the current manual of survey instructions of the United States Department of the Interior, Bureau of Land Management or by a decree of a Court of Law and/or that the corner points mentioned in lines 3, 4 and 5 above were in conformance with the rules of the Michigan Board of Land Surveyors or by a Decree of a Court of Law; established, re-established, monumented, recovered, found as expressed below:

NOTE: Not more than 2 corners, all in the same town and range, may be recorded on this certificate.

	A	B	C	D	E	F	G	H	I	J	K	L	M
1													
2	6		5		4		3		2		1		
3			●										
4	7		8		9		10		11		12		
5													
6	18		17		16		15		14		13		
7													
8	19		20		21		22		23		24		
9													
10	30		29		28		27		26		25		
11													
12	31		32		33		34		35		36		
13													

A. Description of original monument and accessories and/or subsequent restoration:

- 1843 - James A. Mullet: Set post and witnessed
- 1890 - County Surveyor: Set boulder and broken glass for corner and witnessed
- 1977 - Richard L. Miller, P.S.: Found 1" iron in road centerline in line w/old fence to the west, and recorded LCRC (L 1, P 59), and witnessed
- 1996 - Northeast Land Surveys (Bill Woods, P.S.): Found 3/4" pipe, no witnesses given
- 1999 - John F. Oliver, P.S.: Found 3/4" pipe, no witnesses given

APPROVED LAND CORNER
P A 345 of 1990
ALCONA COUNTY

Date: 9-6-2000
County Rep. W.T. Lewis

B. Description of corner evidence found and/or method applied in restoring or reestablishing corner:

Found 1" pipe, 2' East of N/S road c/l, in line w/fence East and West


This corner position is accepted as a careful and faithful perpetuation of the position of the original corner.

C. Description of monument for corner and accessories established to perpetuate locating the position of the corner:

2000 - Placed 3" Alcona County cap, stamped to identify the corner, on 1/2" rerod driven next to pipe in mon. box

Witnesses:

- N 15° E 91.01' 13" Cherry (set tag #41922)
- East 31.32' R.R. Tie (set tag #41922)
- S 35° E 79.79' Power Pole (set tag #41922)
- S 25° W 84.50' 12" Poplar (set tag #41922)
- S 85° W 34.81' Power Pole (set tag #41922)

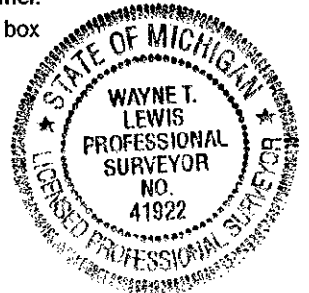

Signed by [Signature]
Surveyor's Michigan License No. 41922

Date September 14, 2000

SURVEY &
REMONUMENTATION

FORM APPROVED BY MICHIGAN STATE BOARD OF PROFESSIONAL SURVEYORS, JAN. 28, 1971
REVISED MAY 14, 1975
REVISED JAN., 1983
REVISED OCT., 1985

FEB 07 2001

SECTION