

2000 Alcona County Remonumentation

LAND CORNER RECORDATION CERTIFICATE  
Filing Requirement of Act 74, Mich. P.A. 1970

For corners in Alcona \_\_\_\_\_ Located In: \_\_\_\_\_ Corner Code # \_\_\_\_\_  
(County)

1. Public Land Survey T 25N R 09E E-5 ✓  
T \_\_\_\_\_ R \_\_\_\_\_  
T \_\_\_\_\_ R \_\_\_\_\_  
T \_\_\_\_\_ R \_\_\_\_\_

2. Property Controlling S \_\_\_\_\_ T \_\_\_\_\_ R \_\_\_\_\_  
in Section S \_\_\_\_\_ T \_\_\_\_\_ R \_\_\_\_\_

3. Miscellaneous S \_\_\_\_\_ T \_\_\_\_\_ R \_\_\_\_\_  
Property in Sec. S \_\_\_\_\_ T \_\_\_\_\_ R \_\_\_\_\_

Alcona County  
Remonumentation  
Liber 2 Page 96

0  
Filed for Record in  
ALCONA COUNTY MICHIGAN  
DORIS A GAUTHIER  
On 09-20-2000 At 09:54 am.  
LAND CORNER 9.00

Register of Deeds Stamp & File Number

4. Lot No. \_\_\_\_\_, Recorded Plat \_\_\_\_\_  
5. Private Claims \_\_\_\_\_

I, Wayne T. Lewis, in a field survey on 3-30-2000, 19\_\_\_\_ do hereby state that under requirements of P.A. 74, Michigan P.A. of 1970, the corner points mentioned in lines 1 and 2 above were in conformance with regulations and rules therefore as required in the current manual of survey instructions of the United States Department of the Interior, Bureau of Land Management or by a decree of a Court of Law and /or that the corner points mentioned in lines 3, 4 and 5 above were in conformance with the rules of the Michigan Board of Land Surveyors or by a Decree of a Court of Law; established, re-established, monumented, recovered, found as expressed below:

NOTE: Not more than 2 corners, all in the same town and range, may be recorded on this certificate.

	A	B	C	D	E	F	G	H	I	J	K	L	M
1													
2	6		5		4		3		2		1		
3													
4	7		8		9		10		11		12		
5					●								
6	10		17		16		15		14		13		
7													
8	19		20		21		22		23		24		
9													
10	30		29		28		27		26		25		
11													
12	31		32		33		34		35		36		
13													

A. Description of original monument and accessories and/or subsequent restoration:

1843 - James A. Mullet: Set post and witnessed  
1983 - Richard Miller, P.S.: Found 3/4" pipe (bar) in center of trail to N.E., and recorded LCRC (L 1, P 119), and witnessed  
1998 - Northeast Land Surveys (Bill Woods, P.S.): Found 5/8" bar, no witnesses given

APPROVED LAND CORNER  
P A 345 of 1990  
ALCONA COUNTY

Date 9-6-2000  
County Rep. W. T. Lewis

B. Description of corner evidence found and/or method applied in restoring or reestablishing corner:

Found 3/4" rod w/hole in top, 9' West of trail to the North, and in line w/meandering fences North and South


This corner position is accepted as a careful and faithful perpetuation of the position of the original corner.

C. Description of monument for corner and accessories established to perpetuate locating the position of the corner:

2000 - Placed 3" Alcona County cap, stamped to identify the corner, on 1/2" rered driven next to existing rod

Witnesses:

- S 75° E 30.05' 18" Aspen (set tag #41922)
- S 45° E 35.39' 8" Oak in Clump (set tag #41922)
- N 05° E 15.24' West Wooden Gate Post (set tag #41922)
- South 43.5'+/- Telephone Box
- S 15° E 52.43' 18" Aspen (set tag #41922)

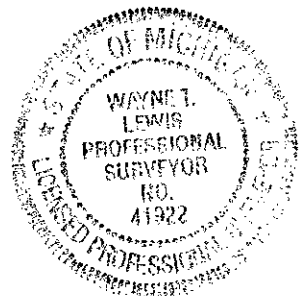

Signed by [Signature]  
Surveyor's Michigan License No. 41922

Date September 14, 2000

SURVEY &  
REMONUMENTATION

FORM APPROVED BY MICHIGAN STATE BOARD OF PROFESSIONAL SURVEYORS, JAN. 28, 1971  
REVISED MAY 14, 1975  
REVISED JAN., 1983  
REVISED OCT., 1995

FEB 07 2001

SECTION