

SURVEY & REMONUMENTATION

APR 24 1995

COMMISSION

1994 Alcona County Remonumentation Corner

Alcona County Remonumentation Liber 1 Page 98

LAND CORNER RECORDATION CERTIFICATE
Filing Requirement of Act 74, Mich. P.A. 1970

RECORDED

For corners in

Alcona
(County)

Located In: _____

Corner Code _____

1. Public Land Survey T 25N R 9E
T _____ R _____
T _____ R _____
T _____ R _____

2. Property Controlling S _____ T _____ R _____
in Section S _____ T _____ R _____

3. Miscellaneous S _____ T _____ R _____
Property in Sec. S _____ T _____ R _____

APPROVED LAND CORNER
P.A. 345 of 1990
ALCONA COUNTY
Date: 12-21-94
County Rep E.T.L.

DEC 21 2 07 PM '94

Janis A. Benthien
REGISTER OF DEEDS
ALCONA COUNTY MICHIGAN

Register of Deeds Stamp & File Number

4. Lot No. _____, Recorded Plat _____
5. Private Claims _____

	A	B	C	D	E	F	G	H	I	J	K	L
2	6	5	4	3	2	1						
3												
4	7	8	9	10	11	12						
5												
6	13	17	16	15	14	13						
7												
8	19	20	21	22	23	24						
9												
10	30	29	28	27	26	25						
11												
12	31	32	33	34	35	36						
13												

David B. Guthrie in a field survey on December 15, 19 94, do hereby certify that under requirements of P.A. 74, Michigan P.A. of 1970, the corner points mentioned in lines 1 and 2 above were in conformance with regulations and rules therefore as required in the current manual of survey instructions of the United States Department of the Interior, Bureau of Land Management or by a decree of a Court of Law and/or that the corner points mentioned in lines 3, 4 and 5 above were in conformance with the rules of the Michigan Board of Land Surveyors or by a Decree of a Court of Law; established, re-established, monumented, re-monumented, recovered, found as expressed below:

NOTE: Not more than 4 corners, all in the same town and range, may be recorded on this certificate.

A. Description of original monument and accessories and/or subsequent restoration:


- 1839: G.L.O. Survey by Lewis Clason - Set Post and Referenced W.Pine 24 - S27W - 45 / W.Pine 22 - S52E - 15
- 1959: Survey by James L. Scott
- 1969: Survey by James L. Scott
- 1971: Survey by James L. Scott
- 1986: Survey by Richard L. Miller

B. Description of corner evidence found and/or method applied in restoring or reestablishing corner:

- 1994: Reset corner by retracement of the 1959 and 1969 Scott surveys and Highway Department ties.

C. Description of monument for corner and accessories established to perpetuate locating the position of the corner:

- 1994: Replaced with 5/8" Iron Rod with 3" Aluminum Cap stamped to identify the Corner.
Referenced -
N10°E - 6" R.Pine - 67.61 Feet
North - 5" Oak - 73.31 Feet
N27°W - 4" Oak - 34.19 Feet
S35°W - 6" R.Pine - 150.71 Feet

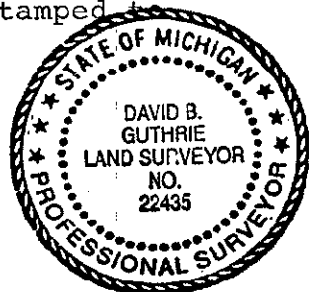

Signed by D.B. Guthrie Date 12/19/94
Surveyor's Michigan License No. 22435