

**SURVEY &
REMONUMENTATION**

APR 24 1995

COMMISSION

1994 Alcona County Remonumentation Corner

Alcona County
Remonumentation
Liber 1 Page 88 **RECORDED**

LAND CORNER RECORDATION CERTIFICATE
Filing Requirement of Act 74, Mich. P.A. 1970

For corners in

<u>Alcona</u> <small>(County)</small>	Located In:	Corner Code #
1. Public Land Survey	T <u>25N</u> R <u>9E</u>	<u>I-3</u>
	T _____ R _____	_____
	T _____ R _____	_____
2. Property Controlling in Section	S _____ T _____ R _____	_____
	S _____ T _____ R _____	_____
3. Miscellaneous Property in Sec.	S _____ T _____ R _____	_____
	S _____ T _____ R _____	_____

APPROVED LAND CORNER
P.A. 345 OF 1990
ALCONA COUNTY
Date 12-19-94
County Rep E.J.L.


DEC 19 12 16 PM

David A. Mullett
REGISTER OF DEEDS
ALCONA COUNTY, MICHIGAN

E.J.L.

Register of Deeds Stamp & File Number

4. Lot No. _____, Recorded Plat _____
5. Private Claims _____

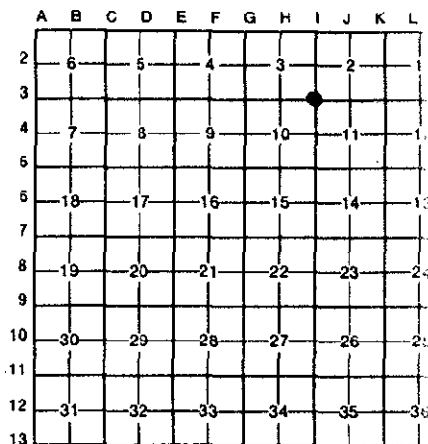

I, David B. Guthrie in a field survey on August 9, 19 94, do hereby certify that under requirements of P.A. 74, Michigan P.A. of 1970, the corner points mentioned in lines 1 and 2 above were in conformance with regulations and rules therefore as required in the current manual of survey instructions of the United States Department of the Interior, Bureau of Land Management or by a decree of a Court of Law and/or that the corner points mentioned in lines 3, 4 and 5 above were in conformance with the rules of the Michigan Board of Land Surveyors or by a Decree of a Court of Law; established, re-established, monumented, re-monumented, recovered, found as expressed below:

NOTE: Not more than 4 corners, all in the same town and range, may be recorded on this certificate.

A. Description of original monument and accessories and/or subsequent restoration:

- 1843: G.L.O. Survey by Mullett & Burt - Set Post and Referenced
Y.Pine 10 - N27E - 37
- 1913: Survey by Andrew J. Freer - Found stone 12x7x10.
- 1918: Survey by A.J. Freer

B. Description of corner evidence found and/or method applied in restoring or reestablishing corner:

1994: Found 1/2" Iron Rod 1 foot North of Ridley Road centerline

C. Description of monument for corner and accessories established to perpetuate locating the position of the corner:

- 1994: Replaced with 5/8" Iron Rod with 3" Brass Cap stamped to identify the Corner placed in a Monument Box.
Referenced -
N06°E - 12" Pine - 59.25 feet
North - Concrete Monument - 33.00 feet
N54°E - 30" W.Pine - 55.21 feet
S27°E - 12" W.Pine - 47.00 feet
S17°W - 15" W.Pine - 34.86 feet



Signed by *David B. Guthrie* Date *Dec. 14, 1994*
Surveyor's Michigan License No. 22435