REMONUMENTATION

APR 2 4 1995

COMMISSION

1994 Alcona County Remonumentation Corner

Alcona County Remonumentation Liber 1 Page 104

RECORDED

DEC 21 2 09 PM '94

Davis A. Guthrie
REGISTER OF DEEDS
ALCONA COUNTY MICHIGAN

LAND CORNER RECORDATION CERTIFICATE

Filing Requirement of Act 74, Mich. P.A. 1970

For corners in

Alcona (County)

	Located In:	Corner Code
1. Public Land Survey	T 25N R 9E	I-7
	T ___ R ___	
	T ___ R ___	
	T ___ R ___	
2. Property Controlling	S ___ T ___ R ___	
in Section	S ___ T ___ R ___	
3. Miscellaneous	S ___ T ___ R ___	
Property in Sec.	S ___ T ___ R ___	

APPROVED LAND CORNER P.A. 345 of 1990 ALCONA COUNTY

Date 12-21-94 County Rep. E.T.L.

E.T.L.

Register of Deeds Stamp & File Number

4. Lot No. _____, Recorded Plat _____
5. Private Claims _____

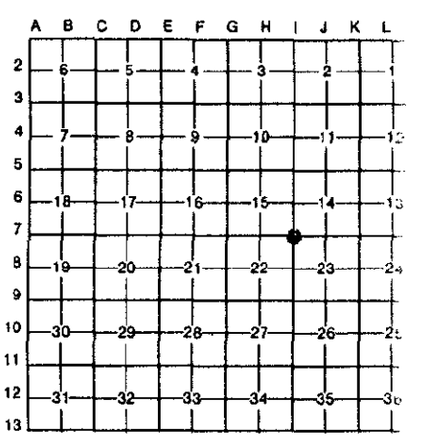

I David B. Guthrie in a field survey on November 10, 1994, do hereby certify that under requirements of P.A. 74, Michigan P.A. of 1970, the corner points mentioned in lines 1 and 2 above were in conformance with regulations and rules therefore as required in the current manual of survey instructions of the United States Department of the Interior, Bureau of Land Management or by a decree of a Court of Law and/or that the corner points mentioned in lines 3, 4 and 5 above were in conformance with the rules of the Michigan Board of Land Surveyors or by a Decree of a Court of Law; established, re-established, monumented, re-monumented, recovered, found as expressed below:

NOTE: Not more than 4 corners, all in the same town and range, may be recorded on this certificate.

A. Description of original monument and accessories and/or subsequent restoration:

1843: G.L.O. Survey by Mullett & Burt - Set Post and Referenced
Cedar 12 - N27E - 32 / W.Pine 10 - S59E - 07
1939: Survey by R.J. Cooke - Plat of Greenbush Acres No. 1
1941: Survey by Ora F. Gould - Plat of Huron-Cedar Lakes Sub. No.1 & No. 2
1947: Survey by Robert S. Scott - Plat of Greenbush Acres No. 3

1993: Survey by Thomas L. Fabis - Found Concrete Monument, Referenced.

B. Description of corner evidence found and/or method applied in restoring or reestablishing corner:

1994: Found Square Concrete Monument, verified 1993 Thomas L. Fabis, references.

C. Description of monument for corner and accessories established to perpetuate locating the position of the corner:

1994: Capped Concrete Monument with a 3" Aluminum Cap stamped to identify the Corner.
Referenced -
S50°E - 12" Cedar - 19.10 feet
S13°W - 12" Ash - 7.60 feet
N50°E - 12" Cedar - 12.35 feet
N21°E - 15" W.Birch - 11.80 feet

STATE OF MICHIGAN
DAVID B. GUTHRIE
LAND SURVEYOR
NO. 22435
PROFESSIONAL SURVEYOR

Signed by D.B. Guthrie Date Dec. 21, 1994

Surveyor's Michigan License No. 22435

FORM APPROVED BY MICHIGAN STATE BOARD OF LAND SURVEYORS, JAN. 28, REVISED MAY 14, REVISED JAN.