APR 2 4 1995

5. Private Claims

COMMISSION

1994 Alcona County Remonumentation Corner

Alcona C	county
Remonu	mentation
Liber	Page <u>9 5.</u>
	N =

		LAND CORNE	R RECORDATION CERTIFICATE	Liber Page 4 S
For corners in		Filing Requirement of Act 74, Mich. P.A. 1970		RECORDED
	Alcona (County)	Located In:	Corner Cook#	Dro 21 0 04 40 4
1.	Public Land Survey	T <u>25N</u> R <u>9E</u> T R T R	I-11 O TO	DEC 21 2 05 PH 194
2.	Property Controlling in Section	T R S T R S T R	ALCA MEDICAL CONTROL OF THE CONTROL	HEGISTER OF DILLOS ALCONA COUNTY BETHIGAN
3.	Miscellaneous Property in Sec.	S T R S T R	<u> </u>	ster of Deeds Stamp & File Number
4.	Lot No	, Recorded Plat		

December 12 IDavid B. Guthrie in a field survey on do hereby certify that under requirements of P.A. 74, Michigan P.A. of 1970, the corner points mentioned in lines 1 and 2 above were in conformance with regulations and rules therefore as required in the current manual of survey instructions of the United States Department of the Interior, Bureau of Land Management or by a decree of a Court of Law and/or that the corner points mentioned in lines 3, 4 and 5 above were in conformance with the rules of the Michigan Board of Land Surveyors or by a Decree of a Court of Law; established, re-established, monumented, re-monumented, recovered, found as expressed below:

NOTE: Not more than 4 corners, all in the same town and range, may be recorded on this certificate.

10 11 12

Description of original monument and accessories and/or subsequent restoration: 1843: G.L.O. Survey by Mullett & Burt - Set Post and Referenced B.Ash 8 - S26E - 24 / Cedar 10 - N36W - 18

1941: Survey by R.J. Cooke - Plat of Martell's Cedar Ridge

1955: Survey by Clarence F. Aikman - Plat of Huron-Cedar Lakes Sub. No. 5


B. Description of corner evidence found and/or method applied in restoring or reestablishing corner:

1994: Found Concrete Monument

C. Description of monument for corner and accessories established to perpetuate locating the position of the corner:

1994: identify the Corner. Referenced -N72°W - 5" Ash - 26.00 Feet S16°W - 7" Ash - 51.60 Feet East - 6" Ash - 47.92 Feet

S70°E - 7" Ash - 42.11 Feet

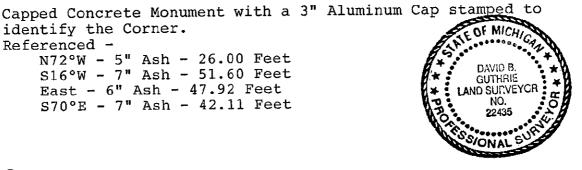

__ Date _