

MAR 03 2000

SECTION

1999 Alcona County Remonumentation

LAND CORNER RECORDATION CERTIFICATE
Filing Requirement of Act 74, Mich. P.A. 1970

For corners in

Alcona

(County)

Located In:

Corner Code #

- 1. Public Land Survey T 26NR 06E F-5
T R
T R
T R
- 2. Property Controlling S T R
in Section S T R
- 3. Miscellaneous S T R
Property in Sec. S T R

Alcona County

Remonumentation

Page 2 Page 4/1

19 0
Filed for Record in
ALCONA COUNTY MICHIGAN
DORIS A GAUTHIER
On 12-17-1999 At 11:01 am.
LAND CORNER 9.00

Register of Deeds Stamp & File Number

- 4. Lot No. _____, Recorded Plat _____
- 5. Private Claims _____

I, Wayne T. Lewis, in a field survey on 9-24, 19 99 do hereby state that under requirements of P.A. 74, Michigan P.A. of 1970, the corner points mentioned in lines 1 and 2 above were in conformance with regulations and rules therefore as required in the current manual of survey instructions of the United States Department of the Interior, Bureau of Land Management or by a decree of a Court of Law and /or that the corner points mentioned in lines 3, 4 and 5 above were in conformance with the rules of the Michigan Board of Land Surveyors or by a Decree of a Court of Law; established, re-established, monumented, recovered, found as expressed below:

NOTE: Not more than 2 corners, all in the same town and range, may be recorded on this certificate.

1	A	B	C	D	E	F	G	H	I	J	K	L	M
2		6		5		4		3		2		1	
3													
4		7		8		9		10		11		12	
5													
6		18		17		16		15		14		13	
7													
8		19		20		21		22		23		24	
9													
10		30		29		28		27		26		25	
11													
12		31		32		33		34		35		36	
13													

A. Description of original monument and accessories and/or subsequent restoration:
1846: James Mullet set post and witnessed
1912: W.S. Freer found Oak post 3x3 with mound of small stone around
Unknown Date: MDOT Plans: 1" iron bar and witnessed
1976: Robert A. Griffin, P.S., found boat spike and witnessed
1987: Sammy S. Barnett, P.S., found 1" axle shaft

B. Description of corner evidence found and/or method applied in restoring or reestablishing corner:
Found 1" iron rod in mon. box, 15' North of E/W C/L, 118' West of Grosse Pte. Rd. C/L


This corner position is accepted as a careful and faithful perpetuation of the position of the original corner.

APPROVED LAND CORNER
P A 345 of 1990
ALCONA COUNTY
Date: 11/30/99
County Rep. D.A.B.C.

C. Description of monument for corner and accessories established to perpetuate locating the position of the corner:
1999: Placed 3" Alcona County cap, stamped to identify the corner, on 1/2" rerod driven next to iron rod

Witnesses:

- N 60° E 92.74' SW corner concrete headwall West side of Grosse Pte. Rd.
- S 60° E 107.08' 14" Oak
- S 40° E 107.40' 17" Oak
- South 90.03' ROW monument
- S 60° W 118.02' 13" Oak

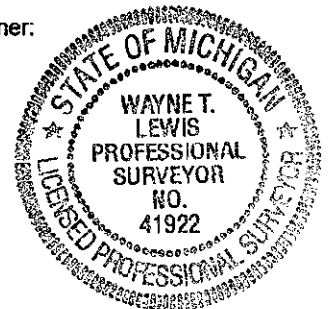

Signed by [Signature]
Surveyor's Michigan License No. 41922

Date December 16, 1999