

MAR 03 2000

1999 Alcona County Remonumentation

LAND CORNER RECORDATION CERTIFICATE
Filing Requirement of Act 74, Mich. P.A. 1970

SECTION

For corners in
Alcona

(County)

Located In:

Corner Code #

1. Public Land Survey

| | | | | |
|---|----|---|-----|-----|
| T | 26 | R | 06E | G-6 |
| T | | R | | |
| T | | R | | |
| T | | R | | |
| S | | T | R | |
| S | | T | R | |
| S | | T | R | |
| S | | T | R | |

2. Property Controlling
in Section

3. Miscellaneous
Property in Sec.

4. Lot No. _____, Recorded Plat _____
5. Private Claims _____

Alcona County
Remonumentation
Book 2 Page 46

U 19 0
Filed for Record in
ALCONA COUNTY MICHIGAN
DORIS A GAUTHIER
On 12-17-1999 At 11:01 am.
LAND CORNER 9.00

Register of Deeds Stamp & File Number

| | | | | | | | | | | | | |
|----|----|----|----|----|----|----|---|---|---|---|---|---|
| A | B | C | D | E | F | G | H | I | J | K | L | M |
| 1 | | | | | | | | | | | | |
| 2 | 6 | 5 | 4 | 3 | 2 | 1 | | | | | | |
| 3 | | | | | | | | | | | | |
| 4 | 7 | 8 | 9 | 10 | 11 | 12 | | | | | | |
| 5 | | | | | | | | | | | | |
| 6 | 18 | 17 | 16 | 15 | 14 | 13 | | | | | | |
| 7 | | | | | | | | | | | | |
| 8 | 19 | 20 | 21 | 22 | 23 | 24 | | | | | | |
| 9 | | | | | | | | | | | | |
| 10 | 30 | 29 | 28 | 27 | 26 | 25 | | | | | | |
| 11 | | | | | | | | | | | | |
| 12 | 31 | 32 | 33 | 34 | 35 | 36 | | | | | | |
| 13 | | | | | | | | | | | | |

I, Wayne T. Lewis, in a field survey on 9-24, 19 99 do hereby state that under requirements of P.A. 74, Michigan P.A. of 1970, the corner points mentioned in lines 1 and 2 above were in conformance with regulations and rules therefore as required in the current manual of survey instructions of the United States Department of the Interior, Bureau of Land Management or by a decree of a Court of Law and /or that the corner points mentioned in lines 3, 4 and 5 above were in conformance with the rules of the Michigan Board of Land Surveyors or by a Decree of a Court of Law; established, re-established, monumented, recovered, found as expressed below:

NOTE: Not more than 2 corners, all in the same town and range, may be recorded on this certificate.

A. Description of original monument and accessories and/or subsequent restoration:

- 1846: James Mullet set post and witnessed
- 1982: John Williams set 5"x36" conc. mon. w/brass cap and witnessed
- 1982: J.F. Oliver set 1/2" bar, no witnesses given
- 1984: R. A. Griffin fd 1/2" rerod w/R.L.S. cap, set 5"x36" conc. mon. w/brass cap & recorded LCRC (L1, P151) & witnessed
- 1997: J. F. Oliver, P.S., found conc. mon. and recorded surveys (L307, P97 and L311, P939), no witnesses given

B. Description of corner evidence found and/or method applied in restoring or reestablishing corner:

Found concrete monument w/brass cap stamped to identify corner w/#13584, corner is 3.6' West of road C/L


This corner position is accepted as a careful and faithful perpetuation of the position of the original corner.

APPROVED LAND CORNER
P A 345 of 1990
ALCONA COUNTY

Date 11/30/99
County Rep. W. T. Lewis

C. Description of monument for corner and accessories established to perpetuate locating the position of the corner:
1999: Used existing concrete monument w/brass cap as remonumentation corner

- Witnesses:
- N 35° E 73.42' 20" White Pine w/bearing tree tag and spike
 - S 70° E 84.16' 20" Red Pine w/bearing tree tag and spike
 - S 40° W 105.63' Power pole
 - S 25° E 87.14' 15" Red Pine w/bearing tree tag and spike
 - West 32.73' Fence post w/bearing tree tag

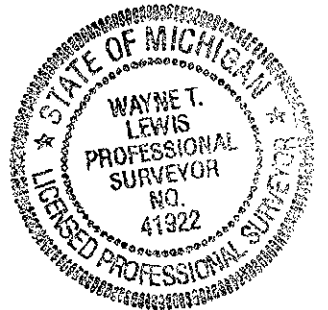

Signed by Wayne T. Lewis
Surveyor's Michigan License No. 41922

Date December 16, 1999