1999 Alcona County Remonumentation

MAR 0 3 2000

SECTION

LAND CORNER RECORDATION CERTIFICATE
Filing Requirement of Act 74, Mich. P.A. 1970

For corners in
Alcona
(County)

	Located In:	Corner Code #
1. Public Land Survey	T 26N R 06E	G-7
	T___ R___	
	T___ R___	
	T___ R___	
2. Property Controlling in Section	S___ T___ R___	
	S___ T___ R___	
3. Miscellaneous Property in Sec.	S___ T___ R___	
	S___ T___ R___	

Alcona County
Remonumentation
Liber 2 Page 47

19 0
Filed for Record in
ALCONA COUNTY MICHIGAN
DORIS A GAUTHIER
On 12-17-1999 At 11:01 am.
LAND CORNER 9.00

Register of Deeds Stamp & File Number

4. Lot No. _____ , Recorded Plat _____
5. Private Claims _____

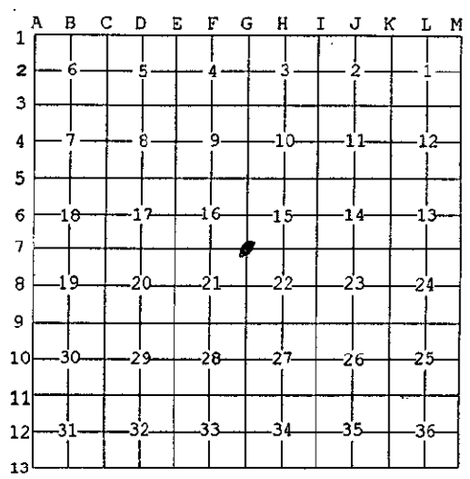

I, Wayne T. Lewis, in a field survey on 9-24, 19 99 do hereby state that under requirements of P.A. 74, Michigan P.A. of 1970, the corner points mentioned in lines 1 and 2 above were in conformance with regulations and rules therefore as required in the current manual of survey instructions of the United States Department of the Interior, Bureau of Land Management or by a decree of a Court of Law and /or that the corner points mentioned in lines 3, 4 and 5 above were in conformance with the rules of the Michigan Board of Land Surveyors or by a Decree of a Court of Law; established, re-established, monumented, recovered, found as expressed below:

NOTE: **Not more than 2 corners, all in the same town and range, may be recorded on this certificate.**

A. Description of original monument and accessories and/or subsequent restoration:
1846: James Mullet set post and witnessed
1982: D.R. MacNeill, P.S. set 1" pipe and recorded surveys (L187, P716; L209, P455; and L194, P960) and witnessed
1982: John Williams set 5"x36" conc. mon. w/brass cap and witnessed
1982: J. F. Oliver set 1/2" bar, no witnesses given
1984: R. A. Griffin found 1/2" rerod w/R.L.S. cap, set 5"x36" conc. mon. w/brass cap & recorded LCRC (L1, P151) & witnessed
1997 and 1998: J. F. Oliver, P.S., found conc. mon. and recorded surveys (L307, P97and L311, P939), no witnesses given

B. Description of corner evidence found and/or method applied in restoring or reestablishing corner:
Fd. conc. mon. w/brass cap stamped to identify corner w/#13584, corner is 4' East of road C/L & in line w/survey line to the West

This corner position is accepted as a careful and faithful perpetuation of the position of the original corner.

APPROVED LAND CORNER
P A 345 of 1990
ALCONA COUNTY
Date 11/30/99
County Rep. [signature]

C. Description of monument for corner and accessories established to perpetuate locating the position of the corner:
1999: Used existing concrete monument w/brass cap as remonumentation corner

Witnesses:
S 30° E 20.87' 12" Aspen
S 35° W 50.93' 8" Cherry w/bearing tree tag and spike
West 32.2' Cedar post w/bearing tree tag and spike, post is loose
West 32.97' 1/2" rerod w/cap #19840
N 50° W 42.58' 8" Oak w/nail and large disk
N 40° W 51.00' 16" Oak w/bearing tree tag and spike

STATE OF MICHIGAN
WAYNE T. LEWIS
PROFESSIONAL SURVEYOR
NO. 41922
LICENSED PROFESSIONAL SURVEYOR

Signed by [signature] Date December 16, 1999
Surveyor's Michigan License No. 41922

FORM APPROVED BY MICHIGAN STATE BOARD OF PROFESSIONAL SURVEYORS, JAN. 28, 1971
REVISED MAY 14,1975
REVISED JAN., 1983
REVISED OCT., 1995