1999 Alcona County Remonumentation

MAR 0 3 2000

SECTION

LAND CORNER RECORDATION CERTIFICATE
Filing Requirement of Act 74, Mich. P.A. 1970

For corners in
Alcona
(County)

Located In: Corner Code #

1. Public Land Survey T 26N R 06E I-5
T___ R___
T___ R___
T___ R___
2. Property Controlling in Section S___ T___ R___
S___ T___ R___
3. Miscellaneous Property in Sec. S___ T___ R___
S___ T___ R___

Alcona County
Remonumentation
Liber 2 Page 44

19 0
Filed for Record in
ALCONA COUNTY MICHIGAN
DORIS A GAUTHIER
On 12-17-1999 At 11:01 am.
LAND CORNER 9.00

Register of Deeds Stamp & File Number

4. Lot No. _____ , Recorded Plat _____
5. Private Claims _____

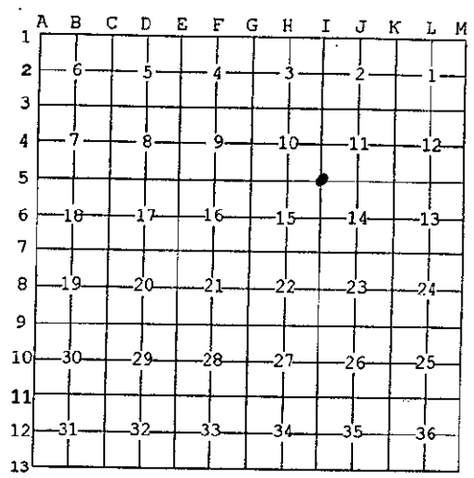

I, Wayne T. Lewis, in a field survey on 9-24, 19 99 do hereby state that under requirements of P.A. 74, Michigan P.A. of 1970, the corner points mentioned in lines 1 and 2 above were in conformance with regulations and rules therefore as required in the current manual of survey instructions of the United States Department of the Interior, Bureau of Land Management or by a decree of a Court of Law and /or that the corner points mentioned in lines 3, 4 and 5 above were in conformance with the rules of the Michigan Board of Land Surveyors or by a Decree of a Court of Law; established, re-established, monumented, recovered, found as expressed below:

NOTE: Not more than 2 corners, all in the same town and range, may be recorded on this certificate.

A. Description of original monument and accessories and/or subsequent restoration:
1846: James Mullet set post and witnessed
1912: W.S. Freer used corner, no monumentation or witnesses given
Unknown Date: MDOT Plans: 1" iron bar and witnessed
1987: S. S. Barnett, P.S., found 1" axle shaft in mon. box and recorded survey (L213, P972) and witnessed

B. Description of corner evidence found and/or method applied in restoring or reestablishing corner:
Found 1" iron rod in mon. box, 10.6' South of E/W C/L and in line w/fence North and South

This corner position is accepted as a careful and faithful perpetuation of the position of the original corner.

APPROVED LAND CORNER
P A 345 of 1990
ALCONA COUNTY
Date 11/30/99
County Rep. D. B. G.

C. Description of monument for corner and accessories established to perpetuate locating the position of the corner:
1999: Placed 3" Alcona County cap, stamped to identify the corner, on 1/2" rerod driven next to iron rod

Witnesses:
South 64.94' 25" Oak
South 65.23' 25" Oak w/MSHD tag
S 25° E 49.45' 8" White Pine
N 20° E 68.54' 12" Oak w/bearing tree tag and spike
North 75.15' South ROW monument
N 40° W 103.94' Fence post

STATE OF MICHIGAN
WAYNE T. LEWIS
PROFESSIONAL SURVEYOR
NO. 41922
LICENSED PROFESSIONAL SURVEYOR

Signed by _____ Date December 16, 1999
Surveyor's Michigan License No. 41922

FORM APPROVED BY MICHIGAN STATE BOARD OF PROFESSIONAL SURVEYORS, JAN. 28, 1971
REVISED MAY 14,1975
REVISED JAN., 1983
REVISED OCT., 1995