

FEB 07 2001

2000 ALCONA COUNTY REMONUMENTATION CORNER

LAND CORNER RECORDATION CERTIFICATE
Filing Requirement of Act 74, Mich. P.A. 1970

SECTION

For corners in

Alcona
(County)

Located In:

Corner Code #

Alcona County
Remonumentation
Liber 2 Page 81

- 1. Public Land Survey T26N R 7E A-2, Millen Twp.
- T26N R 6E M-2, Millen Twp.
- T R _____
- T R _____
- 2. Property Controlling S T R _____
- in Section S T R _____
- 3. Miscellaneous S T R _____
- Property in Sec. S T R _____

Filed for Record in
ALCONA COUNTY MICHIGAN
DORIS A GAUTHIER
On 09-20-2000 At 09:42 am.
LAND CORNER 9.00

Register of Deeds Stamp & File Number

- 4. Lot No. _____, Recorded Plat _____
- 5. Private Claims _____

T26N-R7E

| | A | B | C | D | E | F | G | H | I | J | K | L | M |
|----|----|---|----|---|----|---|----|---|----|---|----|---|---|
| 1 | | | | | | | | | | | | | |
| 2 | 5 | | 5 | | 4 | | 3 | | 2 | | 1 | | |
| 3 | | | | | | | | | | | | | |
| 4 | 7 | | 8 | | 9 | | 10 | | 11 | | 12 | | |
| 5 | | | | | | | | | | | | | |
| 6 | 18 | | 17 | | 16 | | 15 | | 14 | | 13 | | |
| 7 | | | | | | | | | | | | | |
| 8 | 19 | | 20 | | 21 | | 22 | | 23 | | 24 | | |
| 9 | | | | | | | | | | | | | |
| 10 | 30 | | 29 | | 28 | | 27 | | 26 | | 25 | | |
| 11 | | | | | | | | | | | | | |
| 12 | 31 | | 32 | | 33 | | 34 | | 35 | | 36 | | |
| 13 | | | | | | | | | | | | | |

I, Thomas L. Fabis, in a field survey on Sept. 8, 2000 do hereby state that under requirements of P.A. 74, Michigan P.A. of 1970, the corner points mentioned in lines 1 and 2 above were in conformance with regulations and rules therefore as required in the current manual of survey instructions of the United States Department of the Interior, Bureau of Land Management or by a decree of a Court of Law and/or that the corner points mentioned in lines 3, 4 and 5 above were in conformance with the rules of the Michigan Board of Land Surveyors or by a Decree of a Court of Law; established, re-established, monumented, recovered, found as expressed below:

NOTE: Not more than 2 corners, all in the same town and range, may be recorded on this certificate.

A. Description of original monument and accessories and/or subsequent restoration:

- 1838: G.L.O. Survey Lewis Clason set post & referenced: Y. Pine 20 S49W 63, do 26 N46W 16
- 1989: NELS Survey Liber 323 Page 984 John Oliver set bar & cap.
- 1990, 1991, & 1993: R.S.Scott Surveys L.244 P.119-123 & L.271 P.102-104 by David Guthrie existing 1/2" iron rod & referenced.
- 1998: NELS Survey Liber 326 Page 860 Bill Woods visits corner.

B. Description of corner evidence found and/or method applied in restoring or reestablishing corner:

- 2000: Found Bar & Cap (unknown) 5' West of centerline N-S (gravel surface) O'Donnell Road. Found the following witnesses with P.K. nails:
N85W P. Pole 27.87, N80E 44" Oak 39.11, S50E Gate Post 51.05
Also found Forest Service Location Post West 27.8'


The position of this corner is compatible with local surveys and is accepted as a careful and faithful perpetuation of the position of the original corner.

C. Description of monument for corner and accessories established to perpetuate locating the position of the corner:

- 2000: Removed existing plastic cap and replaced with 3" dia. alum. cap, stamped to identify the corner over the existing 1/2" iron rod. Witnesses are as follows:
P.K. nail in P. Pole N85W 27.87
P.K. nail in 44" Oak N80E 39.11
P.K. nail in Gate Post S50E 51.05
Set tag #31591 in 3" R. Pine S38W 51.53

APPROVED LAND CORNER
P A 345 of 1990
ALCONA COUNTY
Date 8-28-2000
County Rep. [Signature]

Signed by Thomas L. Fabis
Surveyor's Michigan License No. 31591

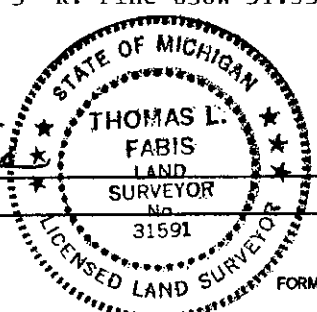

Date September 12, 2000