

SURVEY & REMONUMENTATION

FEB 07 2001

SECTION

2000 ALCONA COUNTY REMONUMENTATION CORNER

LAND CORNER RECORDATION CERTIFICATE

Filing Requirement of Act 74, Mich. P.A. 1970

For corners in

<u>Alcona</u> <small>(County)</small>	Located in:	Corner Code #	
1. Public Land Survey	T <u>26</u> NR <u>7E</u>	B-1, Millen Twp. ✓	
	T <u>27</u> NR <u>7E</u>	B-13, Hawes Twp.	
	T ___ R ___	_____	
	T ___ R ___	_____	
2. Property Controlling in Section	S ___ T ___ R ___	_____	
	S ___ T ___ R ___	_____	
3. Miscellaneous Property in Sec.	S ___ T ___ R ___	_____	
	S ___ T ___ R ___	_____	
4. Lot No. _____, Recorded Plat _____			
5. Private Claims _____			

Alcona County Remonumentation
Liber 2 Page 83

Filed for Record in
ALCONA COUNTY MICHIGAN
DORIS A GAUTHIER
On 09-20-2000 At 09:42 am.
LAND CORNER 9.00

Register of Deeds Stamp & File Number

T26N-R7E

	A	B	C	D	E	F	G	H	I	J	K	L	M
1													
2	6		5		4		3		2		1		
3													
4	7		8		9		10		11		12		
5													
6	18		17		16		15		14		13		
7													
8	19		20		21		22		23		24		
9													
10	30		29		28		27		26		25		
11													
12	31		32		33		34		35		36		
13													

I, Thomas L. Fabis, in a field survey on Sept. 8, 2000 do hereby state that under requirements of P.A. 74, Michigan P.A. of 1970, the corner points mentioned in lines 1 and 2 above were in conformance with regulations and rules therefore as required in the current manual of survey instructions of the United States Department of the Interior, Bureau of Land Management or by a decree of a Court of Law and/or that the corner points mentioned in lines 3, 4 and 5 above were in conformance with the rules of the Michigan Board of Land Surveyors or by a Decree of a Court of Law; established, re-established, monumented, recovered, found as expressed below:

NOTE: Not more than 2 corners, all in the same town and range, may be recorded on this certificate.

A. Description of original monument and accessories and/or subsequent restoration:

1838: G.L.O. Survey Lewis Clason set post & referenced: Cedar 8 N57E 28, do 11 N32W 11

B. Description of corner evidence found and/or method applied in restoring or reestablishing corner:

2000: Did not find any existing monumentation or fence line occupation in this area. Set new corner by single proportionate method. Corner falls 1' South of centerline of E-W (paved surface) Trask Lake Road.


The position of this corner is accepted as a careful and faithful reestablishment of the position of the original corner.

C. Description of monument for corner and accessories established to perpetuate locating the position of the corner:

2000: Set 1/2"x24" iron rod capped with a 3" dia. brass cap, stamped to identify the corner. A Mon. Box was installed over the corner. Established witnesses are:
Fe. Post South 38.20
Fe. Post S40E 51.27
8" Aspen N56E 58.02
6" Aspen N65E 83.20

APPROVED LAND CORNER
P A 345 of 1990
ALCONA COUNTY
Date 8-28-2000
County Rep. [Signature]

Signed by Thomas L. Fabis
Surveyor's Michigan License No. 31591

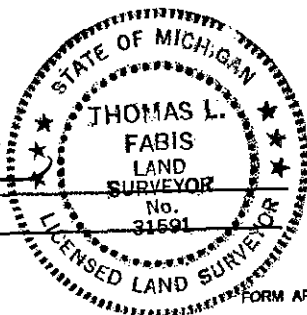

Date September 12, 2000