

SURVEY & REMONUMENTATION

FEB 07 2001

2000 ALCONA COUNTY REMONUMENTATION CORNER

SECTION

LAND CORNER RECORDATION CERTIFICATE Filing Requirement of Act 74, Mich. P.A. 1970

For corners in

Alcona (County)	Located In:	Corner Code #
1. Public Land Survey	T26N R7E	C-5 ✓ Millen Twp.
	T R	
	T R	
	T R	
2. Property Controlling in Section	S T R	
	S T R	
3. Miscellaneous Property in Sec.	S T R	
	S T R	

Alcona County
Remonumentation
Liber 2 Page 75

Filed for Record in
ALCONA COUNTY MICHIGAN
DORIS A GAUTHIER
On 09-20-2000 At 09:42 am.
LAND CORNER 9.00

Register of Deeds Stamp & File Number

4. Lot No. _____, Recorded Plat _____
5. Private Claims _____

	A	B	C	D	E	F	G	H	I	J	K	L	M
1													
2	6		5		4		3		2		1		
3													
4	7		8		9		10		11		12		
5			●										
6	18		17		16		15		14		13		
7													
8	19		20		21		22		23		24		
9													
10	30		29		28		27		26		25		
11													
12	31		32		33		34		35		36		
13													

I, Thomas L. Fabis, in a field survey on Sept. 8, 2000 do hereby state that under requirements of P.A. 74, Michigan P.A. of 1970, the corner points mentioned in lines 1 and 2 above were in conformance with regulations and rules therefore as required in the current manual of survey instructions of the United States Department of the Interior, Bureau of Land Management or by a decree of a Court of Law and /or that the corner points mentioned in lines 3, 4 and 5 above were in conformance with the rules of the Michigan Board of Land Surveyors or by a Decree of a Court of Law, established, re-established, monumented, recovered, found as expressed below:

NOTE: Not more than 2 corners, all in the same town and range, may be recorded on this certificate.

A. Description of original monument and accessories and/or subsequent restoration:

- 1838: G.L.O. Survey Lewis Clason set post & referenced: W. Pine 12 S40W 14, do 12 N9W 28
- 1965: Co. Hwy. Plans Pavement Box & one witness: West 12.80' Hwy. P.I.
- 1975: N.E.L.S. Survey Liber 158 Page 857 John Oliver Boat spike in Mon. Box & referenced.
- No Date: M.D.O.T. R.O.W. Maps Sec. Cor. 0.73' S. of centerline M-72.
- 1989: U.S.D.A. Forest Service Survey L.232 P.907 & 908 and L.C.R.C. L.1 P.407 John Korr Fd. 1-1/4" iron pipe in pavement box and referenced.

B. Description of corner evidence found and/or method applied in restoring or reestablishing corner:

- 2000: Found Boat Spike in Mon. Box 1' South of centerline M-72 paved road, 12.5' East of centerline of N-S (paved surface) Stout Road. Found the following blazed witnesses:
N30W 230 10" Jack Pine, N15E 174.95 10" Red Oak, S13E 188.27 7" Red Oak, S30W 184.74 5" Red Oak

The position of this corner is compatible with Federal, county and local surveys and is accepted as a careful and faithful perpetuation of the position of the original corner.


C. Description of monument for corner and accessories established to perpetuate locating the position of the corner:

- 2000: Removed existing boat spike and set 1/2" iron rod capped with 3" dia. brass cap, stamped to identify the corner, inside the existing Mon. Box. Witnesses are:
Blazed 10" R. Oak N15E 174.95
Blazed 7" R. Oak S13E 188.27
Blazed 5" R. Oak S30W 184.74
Set tag #31591 in 34" Maple N24W 185.19

APPROVED LAND CORNER
P A 345 of 1990
ALCONA COUNTY

Date: 8-21-2000
County Rep. D.P. G... ..

Signed by Thomas L. Fabis
Surveyor's Michigan License No. 31591

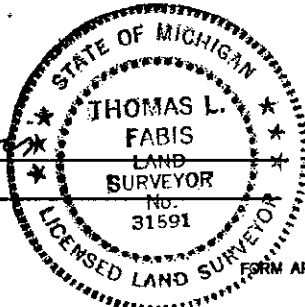

Date September 12, 2000