

# SURVEY & REMONUMENTATION

**FEB 07 2001**

2000 ALCONA COUNTY REMONUMENTATION CORNER

## LAND CORNER RECORDATION CERTIFICATE Filing Requirement of Act 74, Mich. P.A. 1970

For corners in **SECTION**

Alcona <small>(County)</small>	Located in:	Corner Code #	
1. Public Land Survey	T <u>26</u> N R <u>7</u> E	E-3	✓
	T___R___	Millen Twp.	
	T___R___		
	T___R___		
2. Property Controlling in Section	S___T___R___		
	S___T___R___		
3. Miscellaneous Property in Sec.	S___T___R___		
	S___T___R___		

Alcona County  
Remonumentation  
Liber 2 Page 84

Filed for Record in  
ALCONA COUNTY MICHIGAN  
DORIS A GAUTHIER  
On 09-20-2000 At 09:42 am.  
LAND CORNER 9.00

Register of Deeds Stamp & File Number

4. Lot No. \_\_\_\_\_, Recorded Plat \_\_\_\_\_  
5. Private Claims \_\_\_\_\_

I, Thomas L. Fabis, in a field survey on Sept. 8, 2000 do hereby state that under requirements of P.A. 74, Michigan P.A. of 1970, the corner points mentioned in lines 1 and 2 above were in conformance with regulations and rules therefore as required in the current manual of survey instructions of the United States Department of the Interior, Bureau of Land Management or by a decree of a Court of Law and /or that the corner points mentioned in lines 3, 4 and 5 above were in conformance with the rules of the Michigan Board of Land Surveyors or by a Decree of a Court of Law; established, re-established, monumented, recovered, found as expressed below.

**NOTE:** Not more than 2 corners, all in the same town and range, may be recorded on this certificate.

	A	B	C	D	E	F	G	H	I	J	K	L	M
1													
2	6			5			4		3			2	1
3					●								
4	7			8			9		10			11	12
5													
6	10			17			16		15			14	13
7													
8	19			20			21		22			23	24
9													
10	30			29			28		27			26	25
11													
12	31			32			33		34			35	36
13													

- A. Description of original monument and accessories and/or subsequent restoration:**  
 1838: G.L.O. Survey Lewis Clason set post & referenced.  
 1907: County Survey Edw. Chapelle referenced corner.  
 1909: County Survey W.S. Freer cedar stake 6x6  
 1983: Survey Liber 193 Pages 722 & 723 Richard Miller 1/2" Bar & referenced.  
 1984: NELS Survey John Oliver Found Iron.  
 1985: R.S.Scott Survey David Guthrie ex. 1/2" Iron Rod & referenced.  
 1989: U.S.D.A. Forest Service Survey L.232 P.907, 908 & 909 and L.C.R.C. L.1 P.413 by John Korr Fd. 1/2" rebar & replaced w/Conc. Mon. w/brass cap & referenced.  
 1993: NELS Survey Liber 267 Page 36 John Oliver Fd. Iron.


- B. Description of corner evidence found and/or method applied in restoring or reestablishing corner:**  
 2000: Found conc. mon., no brass cap in centerline of E-W gravel road. Found the existing witnesses with spikes tag #24600: S65E 55.23 7" Cedar, S50W 63.48 P. Pole, N38W 80.47 8" Aspen, N78E 116.3 P. Pole  
 Also found carsonite post North 33.9'

The position of this corner is compatible with Federal, county and local surveys and is accepted as a careful and faithful perpetuation of the position of the original corner.

- C. Description of monument for corner and accessories established to perpetuate locating the position of the corner:**  
 2000: Set 3" dia. alum. cap, stamped to identify the corner, over the existing Conc. Mon. Witnesses are:  
 7" Cedar S65E 55.23  
 P. Pole S50W 63.48  
 8" Aspen N38W 80.47  
 Carsonite Post North 33.9  
 Set tag #31591 in Fe. Cor. Post South 33.08

APPROVED LAND CORNER  
P A 345 of 1990  
ALCONA COUNTY  
Date 8-28-2000  
County Rep. T.L.F.

Signed by Thomas L. Fabis  
 Surveyor's Michigan License No. 31591

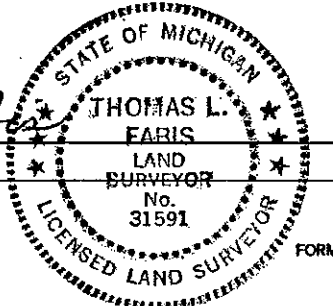

Date September 12, 2000