

SURVEY & REMONUMENTATION

APR 25 1995

1994 Alcona County Remonumentation Corner

COMMISSION

LAND CORNER RECORDATION CERTIFICATE

Filing Requirement of Act 74, Mich. P.A. 1970

Alcona County
Remonumentation

Liber 1 Page 73

RECORDED

For corners in

<u>Alcona</u> (County)	Located In:	Corner Code #
1. Public Land Survey	T <u>26N</u> R <u>7E</u>	<u>G-3</u>
	T _____ R _____	_____
	T _____ R _____	_____
	T _____ R _____	_____
2. Property Controlling in Section	S _____ T _____ R _____	_____
	S _____ T _____ R _____	_____
3. Miscellaneous Property in Sec.	S _____ T _____ R _____	_____
	S _____ T _____ R _____	_____
4. Lot No. _____, Recorded Plat _____		
5. Private Claims _____		

DEC 9 10 33 AM '94

David A. Guthrie
REGISTER OF DEEDS
ALCONA COUNTY MICHIGAN

E.T.C.
Register of Deeds Stamp & File Number

David B. Guthrie in a field survey on June 13, 1994, do hereby certify that under requirements of P.A. 74, Michigan P.A. of 1970, the corner points mentioned in lines 1 and 2 above were in conformance with regulations and rules therefore as required in the current manual of survey instructions of the United States Department of the Interior, Bureau of Land Management or by a decree of a Court of Law and/or that the corner points mentioned in lines 3, 4 and 5 above were in conformance with the rules of the Michigan Board of Land Surveyors or by a Decree of a Court of Law; established, re-established, monumented, re-monumented, recovered, found as expressed below:

	A	B	C	D	E	F	G	H	I	J	K	L
2	6		5		4		3		2		1	
3							●					
4	7		8		9		10		11		12	
5												
6	18		17		16		15		14		13	
7												
8	19		20		21		22		23		24	
9												
10	30		29		28		27		26		25	
11												
12	31		32		33		34		35		36	
13												

NOTE: Not more than 4 corners, all in the same town and range, may be recorded on this certificate.

A. Description of original monument and accessories and/or subsequent restoration:


- 1846: G.L.O. Survey by J.W. Mullett - Set Post and Referenced Hem. 12 - S20E - 30 / Hem. 10 - N36W - 14
- 1903: Survey by Edw. Chapelle - Found Post
- 1910: Survey by W.S. Freer - Found Grey Stone
- 1917: Survey by Edw. Chapelle - Found Dark Grey Boulder 10"x20"
- 1939: Survey by George D. Henning - Found Dark Grey Boulder
- 1986: Survey by D.R. MacNeill and Assoc.

B. Description of corner evidence found and/or method applied in restoring or reestablishing corner:

- 1994: Found P.K. Nail

C. Description of monument for corner and accessories established to perpetuate locating the position of the corner:

- 1994: Replaced with 5/8" Iron Rod with a 3" Brass Cap stamped to identify the corner placed in a Monument Box.
Referenced -
S25°E - Fence Corner - 49.41 feet
S75°W - 10" Tamarack - 68.75 feet
N68° - 4" Apple - 60.08 feet
N28°E - Utility Pole - 96.86 feet

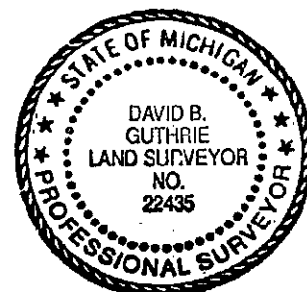

Signed by *D.B. Guthrie*

Date Dec. 8, 1994

Surveyor's Michigan License No. 22435