

REMONUMENTATION

APR 24 1995

COMMISSION

1994 Alcona County Remonumentation Corner

Alcona County Remonumentation

Liber 1 Page 83

LAND CORNER RECORDATION CERTIFICATE

RECORDED

Filing Requirement of Act 74, Mich. P.A. 1970

For corners in

Alcona <small>(County)</small>	Located In:	Corner Code #
1. Public Land Survey	T 26N R 7E	H-1
	T ___ R ___	
	T ___ R ___	
	T ___ R ___	
2. Property Controlling in Section	S ___ T ___ R ___	
	S ___ T ___ R ___	
3. Miscellaneous Property in Sec.	S ___ T ___ R ___	
	S ___ T ___ R ___	

APPROVED LAND CORNER  
PLA 345 of 1990  
ALCONA COUNTY  
Date 12-19-94  
County Rep S. T. L.

DEC 19 12 15 PM '94

David A. Guthrie  
REGISTER OF DEEDS  
ALCONA COUNTY MICHIGAN

E. J. L.

Register of Deeds Stamp & File Number

- 4. Lot No. \_\_\_\_\_, Recorded Plat \_\_\_\_\_
- 5. Private Claims \_\_\_\_\_

A	B	C	D	E	F	G	H	I	J	K	L
2	6	5	4	3	2	1					
3											
4	7	8	9	10	11	12					
5											
6	18	17	16	15	14	13					
7											
8	19	20	21	22	23	24					
9											
10	30	29	28	27	26	25					
11											
12	31	32	33	34	35	36					
13											

David B. Guthrie in a field survey on December 12, 1994, do hereby certify that under requirements of P.A. 74, Michigan P.A. of 1970, the corner points mentioned in lines 1 and 2 above were in conformance with regulations and rules therefore as required in the current manual of survey instructions of the United States Department of the Interior, Bureau of Land Management or by a decree of a Court of Law and/or that the corner points mentioned in lines 3, 4 and 5 above were in conformance with the rules of the Michigan Board of Land Surveyors or by a Decree of a Court of Law; established, re-established, monumented, re-monumented, recovered, found as expressed below:

NOTE: Not more than 4 corners, all in the same town and range, may be recorded on this certificate.

A. Description of original monument and accessories and/or subsequent restoration:

1837: G.L.O. Survey by Lewis Clason - Set Post and Referenced S. Maple 7 - N45E - 20 / W. Pine 10 - N61W - 29

1920: Survey by Andrew J. Freer - Found stone with glass

B. Description of corner evidence found and/or method applied in restoring or reestablishing corner:


1994: Set 1/2" Iron Rod at the intersection of old fencelines North and East.

C. Description of monument for corner and accessories established to perpetuate locating the position of the corner:

1994: Replaced with a 5/8" Iron Rod with a 3" Aluminum Cap stamped to identify the Corner.

Referenced -

- S57°E - 6" Spruce - 36.20 Feet
- S81°E - 24" Maple - 37.24 Feet
- N70°W - 18" Maple - 27.00 Feet
- N20°E - 6" Red Pine - 33.78 Feet

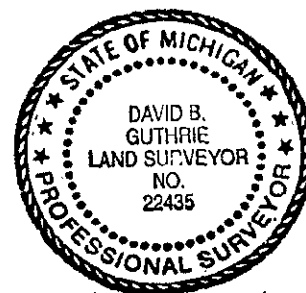

Signed by David B. Guthrie

Date Dec. 16, 1994

Surveyor's Michigan License No. 22435