

**SURVEY &  
REMONUMENTATION**

APR 24 1995

**COMMISSION**

1994 Alcona County Remonumentation Corner

**LAND CORNER RECORDATION CERTIFICATE**  
Filing Requirement of Act 74, Mich. P.A. 1970

Alcona County  
Remonumentation  
Liber 1 Page 84  
**RECORDED**

For corners in


<u>Alcona</u> <small>(County)</small>	Located In:	Corner Code #
1. Public Land Survey	T ___ R ___	<u># 8</u>
	T ___ R ___	
	T ___ R ___	
	T ___ R ___	
2. Property Controlling in Section	S <u>3</u> T <u>26N</u> R <u>7E</u>	H-2
	S ___ T ___ R ___	
3. Miscellaneous Property in Sec.	S ___ T ___ R ___	
	S ___ T ___ R ___	
4. Lot No. _____, Recorded Plat _____		
5. Private Claims _____		

APPROVED LAND CORNER  
P.A. 345 of 1990  
ALCONA COUNTY  
Date: 12-19-94  
County Rep. E.T.L.

DEC 19 12 16 PM '94


*David A. Guthrie*  
REGISTER OF DEEDS  
ALCONA COUNTY MICHIGAN  
**E. T. L.**  
Register of Deeds Stamp & File Number

David B. Guthrie in a field survey on December 17, 1994, do hereby certify that under requirements of P.A. 74, Michigan P.A. of 1970, the corner points mentioned in lines 1 and 2 above were in conformance with regulations and rules therofore as required in the current manual of survey instructions of the United States Department of the Interior, Bureau of Land Management or by a decree of a Court of Law and/or that the corner points mentioned in lines 3, 4 and 5 above were in conformance with the rules of the Michigan Board of Land Surveyors or by a Decree of a Court of Law; established, re-established, monumented, re-monumented, recovered, found as expressed below:

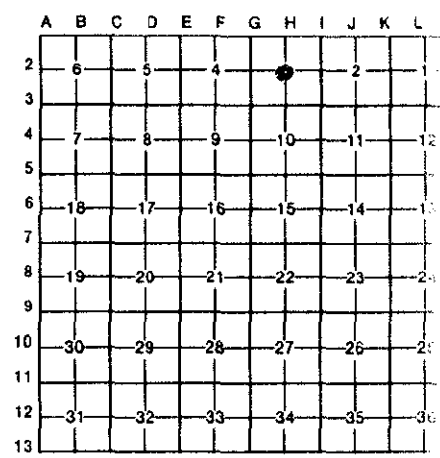

**NOTE: Not more than 4 corners, all in the same town and range, may be recorded on this certificate.**

- A. Description of original monument and accessories and/or subsequent restoration:  
Not a G.L.O. Corner
- B. Description of corner evidence found and/or method applied in restoring or reestablishing corner:  
Set 5/8" Iron Rod at the intersection of the North/South and East/West 1/4 Lines.
- C. Description of monument for corner and accessories established to perpetuate locating the position of the corner:  
Set 5/8" Iron Rod with a 3" Aluminum Cap stamped to identify the Corner.  
Referenced -  
N20°E - Twin 12" Maple - 40.00 Feet  
N45°W - 4" Oak - 30.71 Feet  
S10°W - 10" Maple - 43.44 Feet  
S63°E - 10" Oak - 15.75 Feet  
West - Fence Corner - 38.72 Feet

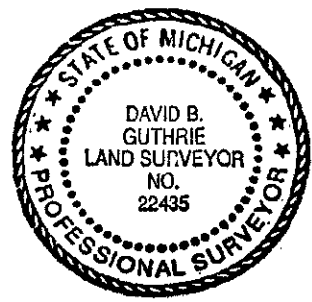

Signed by *D.B. Guthrie* Date December 19, 1994  
Surveyor's Michigan License No. 22435