

SURVEY & REMONUMENTATION

MAR 04 1998

SECTION

1997 Alcona County Remonumentation Corner
LAND CORNER RECORDATION CERTIFICATE
 Filing Requirement of Act 74, Mich. P.A. 1970

APPROVED LAND CORNER
 P A 345 of 1990
ALCONA COUNTY

Date 7-30-97
 County Rep. D.A. Gauthier

For corners in

<u>Alcona</u> (County)	Located In:	Corner Code #
1. Public Land Survey	T <u>26</u> N R <u>8E</u>	<u>C-2</u>
	T ___ R ___	_____
	T ___ R ___	_____
	T ___ R ___	_____
2. Property Controlling in Section	S ___ T ___ R ___	_____
	S ___ T ___ R ___	_____
3. Miscellaneous Property in Sec.	S ___ T ___ R ___	_____
	S ___ T ___ R ___	_____

RECORDED
 Date 10-31 1997
 REMON LIBER 1 PAGE 264
 Time 3:30 PM
Doris A. Gauthier
Doris A. Gauthier
REGISTER OF DEEDS

Register of Deeds Stamp & File Number

4. Lot No. _____, Recorded Plat _____
 5. Private Claims _____

I, Daniel T. Kibbe, in a field survey on July 12, 1997 do hereby state that under requirements of P.A. 74, Michigan P.A. of 1970, the corner points mentioned in lines 1 and 2 above were in conformance with regulations and rules therefore as required in the current manual of survey instructions of the United States Department of the Interior, Bureau of Land Management or by a decree of a Court of Law and /or that the corner points mentioned in lines 3, 4 and 5 above were in conformance with the rules of the Michigan Board of Land Surveyors or by a Decree of a Court of Law; established, re-established, monumented, recovered, found as expressed below:


NOTE: Not more than 2 corners, all in the same town and range, may be recorded on this certificate.

	A	P	C	D	E	F	G	H	I	J	K	L	M
1													
2	6		●	5		4		3		2		1	
3													
4	7		8		9		10		11		12		
5													
6	18		17		16		15		14		13		
7													
8	19		20		21		22		23		24		
9													
10	30		29		28		27		26		25		
11													
12	31		32		33		34		35		36		
13													

A. Description of original monument and accessories and/or subsequent restoration:
 1843: GLO Survey by James H. Mullett - Set ¼ Sec. post, referenced: W. Pine 16 - S 33 W - 14 / Y. Pine 16 - S 64 E - 26.
 1988: Survey and L.C.R.C. by Robert F. Mitchell - set 5" x 60" con. mon. w/brass cap, referenced: N36E - 6" Hard Maple - 17.60' / N68E - 12" W. Oak - 43.96' / S 19W - 12" Red Oak - 17.07' / S73W - 10" Red Oak - 7.80'.

B. Description of corner evidence found and/or method applied in restoring or reestablishing corner:
 1997: Found concrete monument with brass cap.
 This corner position is accepted as a careful and faithful perpetuation of the position of the original corner.

C. Description of monument for corner and accessories established to perpetuate locating the position of the corner:
 1997: Found concrete monument with brass cap. Fence to the North and East.
 Referenced:
 S73W-7.75'-Found spike in 9" dead oak
 S15W-17.15'-Found spike in 9" oak
 N65E-43.98'-Found spike in 10" oak
 N35E-17.56'-Found spike in 6" maple

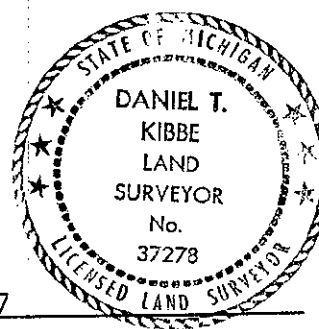

Signed by *Daniel T. Kibbe*
 Surveyor's Michigan License No. 37278

Date October 22, 1997