

LAND CORNER RECORDATION CERTIFICATE
Filing Requirement of Act 74, Mich. P.A. 1970

RECORDED

For corners in

<u>Alcona</u> <small>(County)</small>	Located In:	Corner Code #
1. Public Land Survey	T <u>26N</u> R <u>8E</u>	<u>K-2</u>
	T _____ R _____	_____
	T _____ R _____	_____
2. Property Controlling in Section	S _____ T _____ R _____	_____
	S _____ T _____ R _____	_____
3. Miscellaneous Property in Sec.	S _____ T _____ R _____	_____
	S _____ T _____ R _____	_____

Remon 1 Page 25

DEC 20 1 20 PM '93

Janis A. Penttila
REGISTER OF DEEDS
ALCONA COUNTY, MICHIGAN

Register of Deeds Stamp & File Number

4. Lot No. _____, Recorded Plat _____
5. Private Claims _____

I, David B. Guthrie in a field survey on Aug. 25, 19 93, do hereby certify that under requirements of P.A. 74, Michigan P.A. of 1970, the corner points mentioned in lines 1 and 2 above were in conformance with regulations and rules therefore as required in the current manual of survey instructions of the United States Department of the Interior, Bureau of Land Management or by a decree of a Court of Law and/or that the corner points mentioned in lines 3, 4 and 5 above were in conformance with the rules of the Michigan Board of Land Surveyors or by a Decree of a Court of Law; established, re-established, monumented, re-monumented, recovered, found as expressed below:

NOTE: Not more than 4 corners, all in the same town and range, may be recorded on this certificate.

A	B	C	D	E	F	G	H	I	J	K	L
2	6	5	4	3	2	1					
3											
4	7	8	9	10	11	12					
5											
6	18	17	16	15	14	13					
7											
8	19	20	21	22	23	24					
9											
10	30	29	28	27	26	25					
11											
12	31	32	33	34	35	36					
13											

A. Description of original monument and accessories and/or subsequent restoration:

1843: G.L.O. Survey by Lewis Clason - Set post and referenced Cedar 8 - S23°W - 11 / Cedar 8 - S44°E - 05

1989: Survey by Larry G. Beauregard - Found 1/2" Iron Ron in Monument Box

B. Description of corner evidence found and/or method applied in restoring or reestablishing corner:

1993: Found 1/2" Iron Rod in Monument Box in the center of Highway F-41


SURVEY &
REMONUMENTATION

1993

COMMISSION

C. Description of monument for corner and accessories established to perpetuate locating the position of the corner:

1993: Set a 3" brass cap stamped to identify the corner on a 1/2" Iron Rod. Referenced:
N48°W - Utility Pole - 82.80 Feet
S32°W - Utility Pole - 93.55 Feet
N48°E - Utility Pole - 104.95 Feet
S28°W - R.O.W. Marker - 112.45 Feet

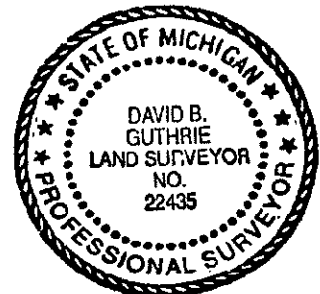

Signed by *David B. Guthrie*

Date 12-20-93

Surveyor's Michigan License No. 22435