1993 Alcona County Remonumentation Corner

001 PAGE 27

LAND CORNER RECORDATION CERTIFICATE

Filing Requirement of Act 74, Mich. P.A. 1970

RECORDED

Remon 1 Page 27

DEC 20 1 20 PM '93

REGISTER OF DEEDS
ALCONA COUNTY, MICHIGAN

Register of Deeds Stamp & File Number

For corners in

Alcona (County)

	Located In:	Corner Code ##
1. Public Land Survey	T 26N R 8E	K-4
	T ___ R ___	
	T ___ R ___	
	T ___ R ___	
2. Property Controlling	S ___ T ___ R ___	
in Section	S ___ T ___ R ___	
3. Miscellaneous	S ___ T ___ R ___	
Property in Sec.	S ___ T ___ R ___	

4. Lot No. _____ , Recorded Plat _____
5. Private Claims _____

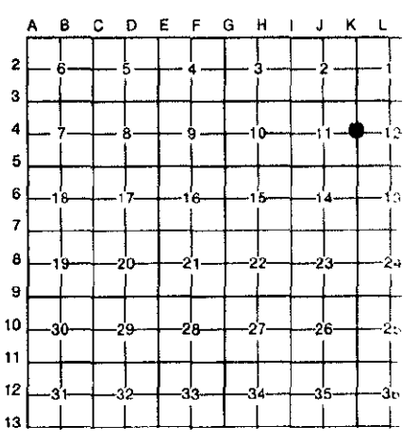

I, David B. Guthrie, in a field survey on August 25, 19 93, do hereby certify that under requirements of P.A. 74, Michigan P.A. of 1970, the corner points mentioned in lines 1 and 2 above were in conformance with regulations and rules therefore as required in the current manual of survey instructions of the United States Department of the Interior, Bureau of Land Management or by a decree of a Court of Law and/or that the corner points mentioned in lines 3, 4 and 5 above were in conformance with the rules of the Michigan Board of Land Surveyors or by a Decree of a Court of Law; established, re-established, monumented, re-monumented, recovered, found as expressed below:

NOTE: Not more than 4 corners, all in the same town and range, may be recorded on this certificate.

A. Description of original monument and accessories and/or subsequent restoration:

1843: G.L.O. Survey by Lewis Clason - A 10" Spruce was used as the corner. Referenced - Maple stp. 6 - N - 5/ Hem. stump 22 - S32°E - 30
1962: Survey by M.S.H.D. - Set 1/2" Bar in Monument Box
1988: Survey by David B. Guthrie - Found 1/2" Iron Rod in Monument Box, Referen

B. Description of corner evidence found and/or method applied in restoring or reestablishing corner:

1993: Found 1/2" Iron Rod in Monument box in the center of Highway F-41 at the intersection of a Fence West.

SURVEY &
REMONUMENTATION

1993

COMMISSION

C. Description of monument for corner and accessories established to perpetuate locating the position of the corner:

1993: Set a 1/2" x 24" Iron Rod with a 3" brass cap stamped to identify the corner. Referenced:
West - Utility Pole - 44.18 Feet
N87°W - Fence Corner - 49.52 Feet
S88°E - 30" Maple - 50.05 Feet
N50°E - 60" Aspen - 75.60 Feet

STATE OF MICHIGAN
DAVID B. GUTHRIE
LAND SURVEYOR
NO. 22435
PROFESSIONAL SURVEYOR

Signed by _____ Date 12-20

Surveyor's Michigan License No. 22435

FORM APPROVED BY MICHIGAN STATE BOARD OF LAND SURVEYORS, JAN. 28,
REVISED MAY 14,
REVISED JAN.