

LAND CORNER RECORDATION CERTIFICATE
Filing Requirement of Act 74, Mich. P.A. 1970

For corners in

Table with columns: Alcona (County), Located In, Corner Code #. Includes entries for Public Land Survey, Property Controlling in Section, and Miscellaneous Property in Sec.

RECORDED

Remon 1 Page 28

DEC 20 1 20 PM '93

Signature of David B. Guthrie, Registered Professional Surveyor, Alcona County, Michigan

Register of Deeds Stamp & File Number

- 4. Lot No. , Recorded Plat
5. Private Claims

Grid table with columns A-L and rows 1-13. A dot is marked at the intersection of column J and row 5.

I, David B. Guthrie in a field survey on August 25, 1993, do hereby certify that under requirements of P.A. 74, Michigan P.A. of 1970, the corner points mentioned in lines 1 and 2 above were in conformance with regulations and rules therefore as required in the current manual of survey instructions of the United States Department of the Interior, Bureau of Land Management or by a decree of a Court of Law and/or that the corner points mentioned in lines 3, 4 and 5 above were in conformance with the rules of the Michigan Board of Land Surveyors or by a Decree of a Court of Law; established, re-established, monumented, re-monumented, recovered, found as expressed below:

NOTE: Not more than 4 corners, all in the same town and range, may be recorded on this certificate.

A. Description of original monument and accessories and/or subsequent restoration:

- 1843: G.L.O. Survey by Lewis Clason - Set post and referenced Fir 8 - S10°W - 6/Fir 6 - S28°E - 10/Fir 10 - S52°W - 24
1901: Survey by Edw. Chappelle Sr. - Set I-Iron
\*1911: Survey By A.J. Freer Jr. - Found T-Iron
1992: Survey by Thomas F. Fabis - Found 1/2" Iron Rod in Monument Box.
\* 1962: Survey by M.S.H.D. - Axel Shaft in Monument Box.

B. Description of corner evidence found and/or method applied in restoring or reestablishing corner:


1993: Found Concrete Monument in Monument Box at the Intersection of Highways F-41 and M-72.

SURVEY & REMONUMENTATION

1003

C. Description of monument for corner and accessories established to perpetuate locating the position of the corner:

1993: Placed 3" brass cap stamped to identify the corner on a Concrete Monument. Referenced:
N24°W - Utility Pole - 87.68 Feet
S26°W - Utility Pole - 73.10 Feet
N42°E - Utility Pole - 70.60 Feet
S60°W - Utility Pole - 114.15 Feet

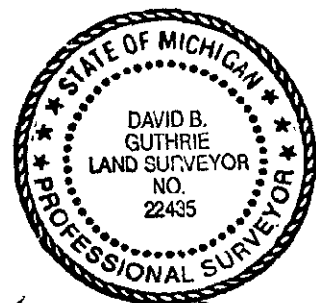

Signed by [Signature] Date 12-20-93

Surveyor's Michigan License No. 22435