

DEC 17 1 44 PM '93

1993 Alcona County Remonumentation Corner

LAND CORNER RECORDATION CERTIFICATE
Filing Requirement of Act 74, Mich. P.A. 1970

Janis A. Gauthier
REGISTER OF DEEDS
ALCONA COUNTY, MICHIGAN

For corners in

<u>Alcona</u> <small>(County)</small>	Located In:	Corner Code #
1. Public Land Survey	T 26N R 8E	M-1(NE,1) (Gustin Twp.)
	T _____ R _____	_____
	T _____ R _____	_____
	T _____ R _____	_____
2. Property Controlling in Section	S _____ T _____ R _____	_____
	S _____ T _____ R _____	_____
3. Miscellaneous Property in Sec.	S _____ T _____ R _____	_____
	S _____ T _____ R _____	_____
4. Lot No. _____, Recorded Plat _____		
5. Private Claims _____		

Register of Deeds Stamp & File Number

I, Thomas L. Fabis in a field survey on November 30, 1993

do hereby certify that under requirements of P.A. 74, Michigan P.A. of 1970, the corner points mentioned in lines 1 and 2 above were in conformance with regulations and rules therefore as required in the current manual of survey instructions of the United States Department of the Interior, Bureau of Land Management or by a decree of a Court of Law and/or that the corner points mentioned in lines 3, 4 and 5 above were in conformance with the rules of the Michigan Board of Land Surveyors or by a Decree of a Court of Law; established, re-established, monumented, re-monumented, recovered, found as expressed below:

NOTE: Not more than 4 corners, all in the same town and range, may be recorded on this certificate.

A	B	C	D	E	F	G	H	I	J	K	L	M
2	6	5	4	3	2	1						
3												
4	7	8	9	10	11	12						
5												
6	18	17	16	15	14	13						
7												
8	19	20	21	22	23	24						
9												
10	30	29	28	27	26	25						
11												
12	31	32	33	34	35	36						
13												

A. Description of original monument and accessories and/or subsequent restoration:

- 1838: G.L.O. Survey by Lewis Clason - Set post (Beech 10 N36E 50, Beech 12 S64W 23)
- 1973: L.C.R.C. Liber 1 Page 21 by Richard Miller - Found Iron Pipe and witnessed (N65°E - P.P. - 60.85', S40°E - P.P. - 70.25', and S65°W - Tel. P. - 68.43')
- 1975 thru 1986: Various Recorded Surveys Liber 186 Page 58, Liber 207 Page 356, Liber 163 page 132, Liber 173 Page 963, Liber 163 Page 126-7, Liber 159 Page 37, Liber 172 Page 905, and Liber 181 Page 687: P.K. nail in Iron Pipe.

B. Description of corner evidence found and/or method applied in restoring or reestablishing corner:

- 1993: Found Iron Pipe and 3 witnesses as per L.C.R.C. Liber 1 Page 21 and is accepted as a careul and faithful perpetuation of the position of the original corner.
- The distance between the N.E. corner and the E $\frac{1}{2}$ corner of Section 1 checks with the various recorded surveys mentioned above.


SURVEY & REMONUMENTATION

1993

COMMISSION

C. Description of monument for corner and accessories established to perpetuate locating the position of the corner:

- 1993: Removed existing corner material and set 5/8" iron rod with brass cap in Mon. Box during a Road Improvement Project for Alcona County Road Commission.
- Reestablished witnesses are:
- Exis. Witness Tag in P. Pole - S55°E - 70.43'
- Exis. Witness tag in P. Pole - N60°E - 61.00'
- Set tag #31591 in 8" Maple - S40°W - 81.86'
- Set tag #31591 in T. Pole - S60°W - 69.82'

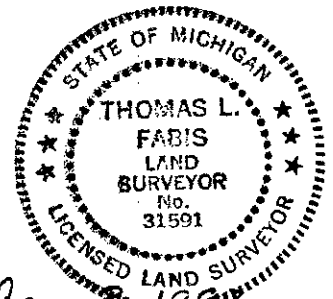

Signed by Thomas L. Fabis Date December 9, 1993
Surveyor's Michigan License No. 31591