

**SURVEY &
REMONUMENTATION**

001 PAGE 02

1993

1993 Alcona County Remonumentation Corner

COMMISSION

**LAND CORNER RECORDATION CERTIFICATE
Filing Requirement of Act 74, Mich. P.A. 1970**

RECORDED
REMON Liber 1 Page 2

For corners in

Alcona

(County)

Located In:

Corner Code #:

- | | | | | | |
|---------------------------------------|---|------------|---|-----------|--|
| 1. Public Land Survey | T | <u>26N</u> | R | <u>8E</u> | M-2(E $\frac{1}{2}$,1)
(Gustin Twp.) |
| | T | _____ | R | _____ | _____ |
| | T | _____ | R | _____ | _____ |
| | T | _____ | R | _____ | _____ |
| 2. Property Controlling
in Section | S | _____ | T | _____ | _____ |
| | S | _____ | T | _____ | _____ |
| 3. Miscellaneous
Property in Sec. | S | _____ | T | _____ | _____ |
| | S | _____ | T | _____ | _____ |
4. Lot No. _____, Recorded Plat _____
5. Private Claims _____

DEC 17 1 44 PM '93

Doris A. Gauthier
REGISTER OF DEEDS
ALCONA COUNTY, MICHIGAN

Register of Deeds Stamp & File Number

I, Thomas L. Fabis, in a field survey on November 30, 1993, do hereby certify that under requirements of P.A. 74, Michigan P.A. of 1970, the corner points mentioned in lines 1 and 2 above were in conformance with regulations and rules therefore as required in the current manual of survey instructions of the United States Department of the Interior, Bureau of Land Management or by a decree of a Court of Law and/or that the corner points mentioned in lines 3, 4 and 5 above were in conformance with the rules of the Michigan Board of Land Surveyors or by a Decree of a Court of Law; established, re-established, monumented, re-monumented, recovered, found as expressed below:

NOTE: Not more than 4 corners, all in the same town and range, may be recorded on this certificate.

	A	B	C	D	E	F	G	H	I	J	K	L	M
2	6		5		4		3		2		1		
3													
4	7		8		9		10		11		12		
5													
6	18		17		16		15		14		13		
7													
8	19		20		21		22		23		24		
9													
10	30		29		28		27		26		25		
11													
12	31		32		33		34		35		36		
13													

A. Description of original monument and accessories and/or subsequent restoration:


- 1838: G.L.O. Survey by Lewis Clason - Set post (W. Pine 26 S55°W 10, W. Pine 12 N57W 22)
- 1973: L.C.R.C. Liber 1 Page 21 by Richard Miller - Set 1/2" iron rod midway between NE Cor. and SE Cor. Section 1 and witnessed (N 40° W - 10" Poplar - 55.51', S 45° W - 8" Beech - 44.55', East - F.P. - 32.94')
- 1975 thru 1986: Various Recorded Surveys Liber 186 Page 58, Liber 207 Page 356, Liber 163 Page 132, Liber 154 Page 152, Liber 173 Page 963, Liber 163 Page 126, Liber 159 Page 37 and Liber 181 Page 687: 1/2" iron rod.

B. Description of corner evidence found and/or method applied in restoring or reestablishing corner:

- 1993: Found 1/2" iron rod and one witness (S45°W - 8" Beech - 44.55') as per L.C.R.C. Liber 1, Page 21 and is accepted as a careful and faithful perpetuation of the reestablishment of the position of the original corner.
The distance between the NE corner and the E $\frac{1}{2}$ corner of Section 1 checks with the various recorded surveys mentioned above.

C. Description of monument for corner and accessories established to perpetuate locating the position of the corner:

- 1993: Removed existing corner material and set 5/8" iron rod with brass cap in Mon. Box during a Road Improvement Project for Alcona County Road Commission.
Reestablished witnesses are:
Set tag #31591 in 8" Aspen - N55°W - 76.60'
Set tag #31591 in 6" W. Pine - N80°W - 66.15'
Set tag #31591 in 12" Beech - S70°W - 43.40'
4" dia. steel fence post - East - 70.63'

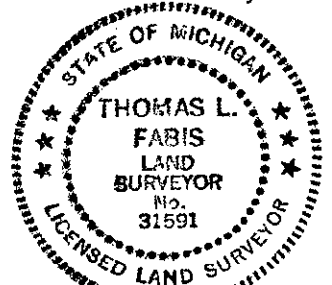

Signed by Thomas L. Fabis

Date December 8, 1993

Surveyor's Michigan License No. 31591