

1993 Alcona County Remonumentation Corner

LAND CORNER RECORDATION CERTIFICATE
Filing Requirement of Act 74, Mich. P.A. 1970

Remon RECORDED
Liber 1 Page 3

For corners in

Alcona (County) Located In: Corner Code #
1. Public Land Survey T 26N R 8E M-3(SE,1) (Gustin Twp.)
2. Property Controlling in Section S T R
3. Miscellaneous Property in Sec. S T R
4. Lot No. Recorded Plat
5. Private Claims

DEC 17 1 44 PM '93

Marie A. Gauthier
REGISTER OF DEEDS
ALCONA COUNTY, MICHIGAN

Register of Deeds Stamp & File Number

I, Thomas L. Fabis in a field survey on November 30, 1993 do hereby certify that under requirements of P.A. 74, Michigan P.A. of 1970, the corner points mentioned in lines 1 and 2 above were in conformance with regulations and rules therefore as required in the current manual of survey instructions of the United States Department of the Interior, Bureau of Land Management or by a decree of a Court of Law and/or that the corner points mentioned in lines 3, 4 and 5 above were in conformance with the rules of the Michigan Board of Land Surveyors or by a Decree of a Court of Law; established, re-established, monumented, re-monumented, recovered, found as expressed below:

Grid table with columns A-M and rows 2-13. A dot is present in row 3, column M.


NOTE: Not more than 4 corners, all in the same town and range, may be recorded on this certificate.

- A. Description of original monument and accessories and/or subsequent restoration:
1838: G.L.O. Survey by Lewis Clason - Set post (Maple 11 S50 W 56, Maple 14 N17W 53)
1973: L.C.R.C. Liber 1 Page 21 by Richard Miller - Sound 1" steel rod and witnessed N84°W - F.P. - 33.50', S45°W - P.P. - 42.50', and N45°E - Tel. P. - 54.36')
1973: Recorded Survey Liber 154 Page 152 by Richard Miller - Found 1" steel rod and witnessed same as L.C.R.C. Liber 1 Page 21.

- B. Description of corner evidence found and/or method applied in restoring or reestablishing corner:
1993: Found 1" steel rod and one witness (S45°W - P.P. - 42.50) as per L.C.R.C. Liber 1 Page 21 and Recorded Survey Liber 154 Page 152 and is accepted as a careful and faithful perpetuation of the position of the original corner.
The distance between the S.E. Cor. Sec 1 and the E 1/4 Cor. Sec 1g checks with Recorded Survey Liber 154 Page 152.

SURVEY & REMONUMENTATION
1993
COMMISSION

- C. Description of monument for corner and accessories established to perpetuate locating the position of the corner:
1993: Removed existing corner material and set 5/8" iron rod with brass cap in Mon. Box during a Road Improvement Project for Alcona County, Road Commission.
Reestablished witnesses are:
Set tag #31591 in F. Post - N55°E - 52.32'
Set tag #31591 in 20" Beech - N75°W - 53.56'
Set tag #31591 in 20" Twin Maple - N45°W 75.95'
Exis tag in P. Pole - S45°W - 42.50'

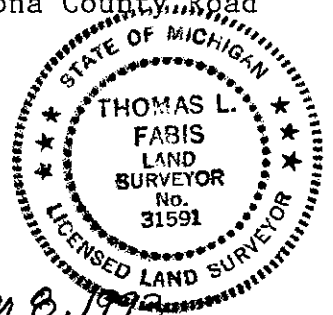

Signed by Thomas L. Fabis
Surveyor's Michigan License No. 31591

Date December 8, 1993